No. 170.

Survey made in Section twenty one Town four Range five July 21 1857 by James Wilson Jr. Dept. Co. Surveyor

21 — 4 — 5

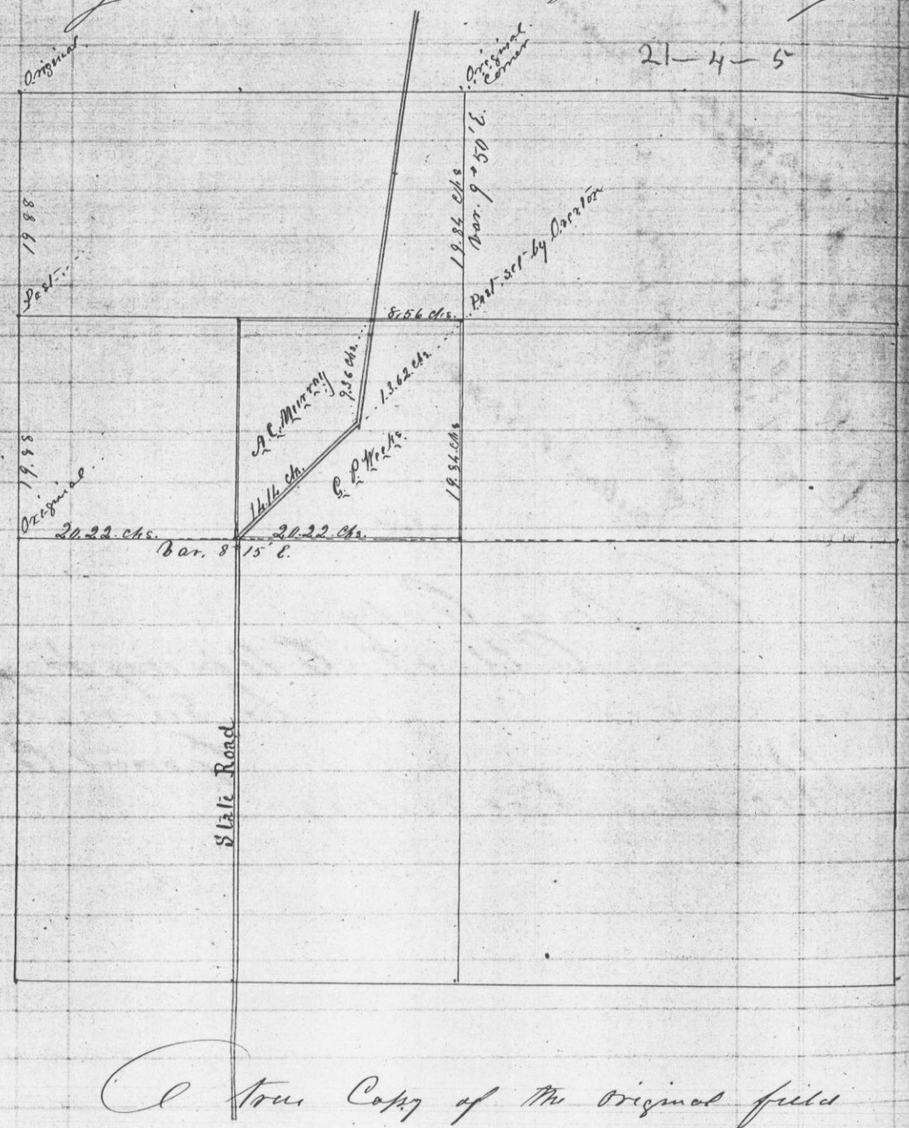

A True Copy of the original field Notes

Attest C. Whitney Hayden
Co. Surveyor

Recorded Jan. 23. 1858

No. 171.

Survey made July 11. 1857 by James Wilson Jr. Dept. Co. Surveyor in Section 12. Town 3 Range 5 & Section 7 Town 3 Range 4.

12 — 3 — 5
7 — 3 — 4

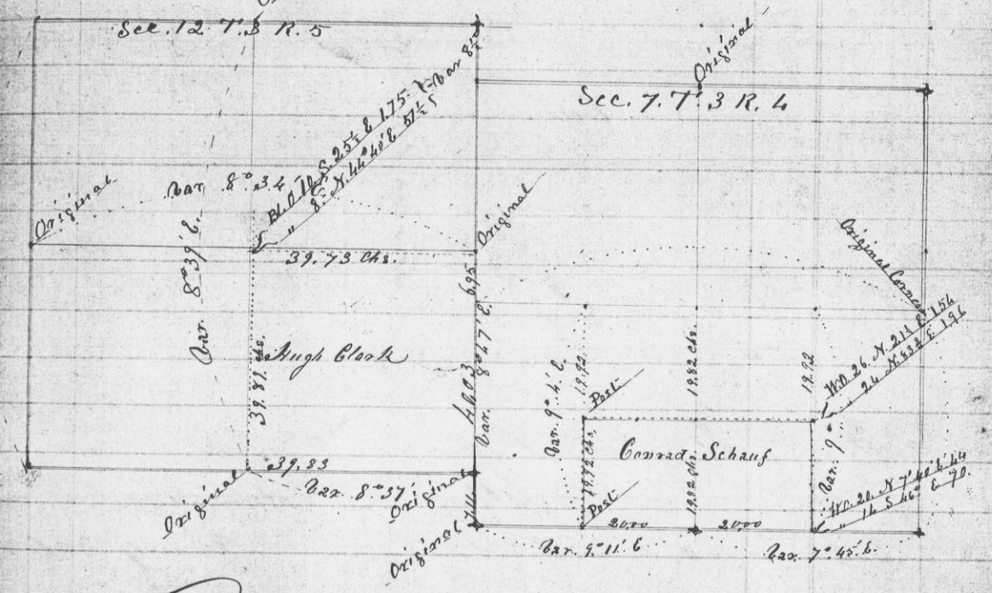

A True Copy of the field notes of said Survey.

Attest C. Whitney Hayden
Co. Surveyor

Recorded Jan. 23. 1858