No 194

Plat of the N.W. qu. of Sec 3 Township 2 Range 3 West
North

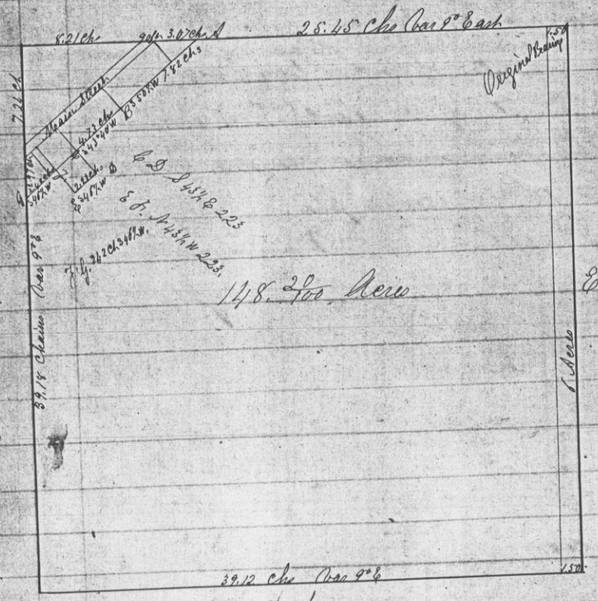

State of Wisconsin
County of Grant } ss

I hereby certify that the above plat is a true copy of a survey made by me on the 13th & 15th days of November AD 1858

C. Whitney Hayden
County Surveyor

Recorded Nov 24th 1858
Attest John G. Clark
Deputy Surveyor

8.21
44
492.6
492.6
541.86

3.25
166
521

Sect. 25. T. 3. R. 5. West

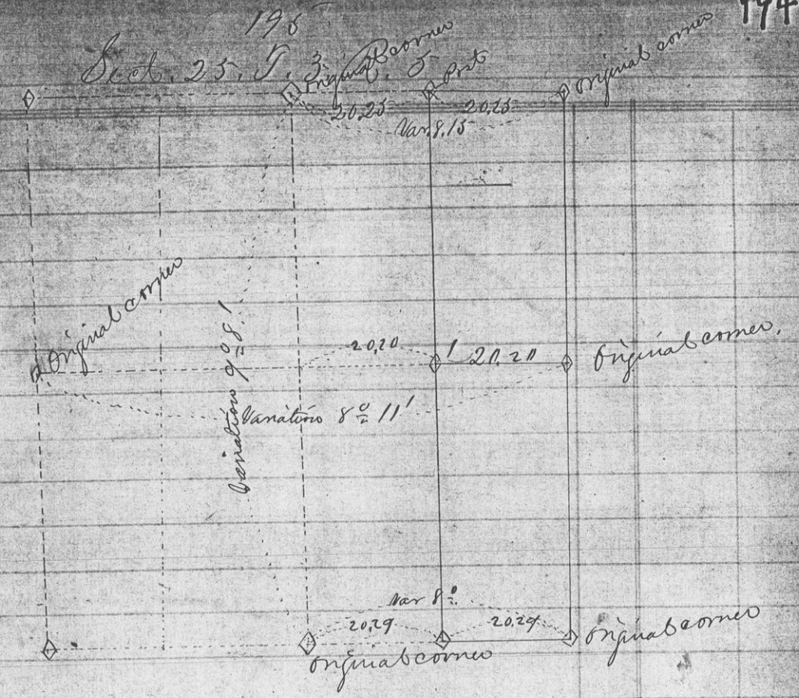

State of Wisconsin, }
County of Grant. } ss.

I, C. W. Hayden, Surveyor in and for the aforesaid County, do hereby certify that I have surveyed and subdivided sect. No. 25 in T. 3 R. 5 West of 4th P.M. as shown on the above map is a correct representation of said survey.

1 { Aspen 12 S. 78¾ E. 21 / W. Oak 6 N. 4½ W. 41. } Var. 8½°

Given under my hand this 14th day of Jan AD. 1858.

C. W. Hayden.
County Surveyor,
By James Wilson Jr.
Deputy.

Recorded Jany. 1st 1859.