shows it to be 123 2/3 feet but the figures call for 14
feet which I think is an error of 21 feet which is
front of Lot 83. making a total distance of 14
feet from the intersection of Main and Mineral Stre
to the division line of Lots Nos 83 & 84 which agree
with the Scale of the Original Map. I also
established the division line between Lots Nos 82,
& 84 at right angles to Mineral Street. They were
drafted at right angles on the original map but n
bearings were given. I also find there are erro
in the distances given on the rear and diagonal li
on the original map, also the distance on the North
or division between Lots 83 & 84 calls for 185 feet,
the true distance is 158 1/4 feet which was without do
a misplacement of the figures 5 & 8. The area of Lo
83 as I have established it is 23/100 acres, the same a
called for on the original map. I planted stone
on the rear of lot 83 as shown on the accompany
map and I further certify that the accompanyin
map is a correct representation of said Survey
Variation of needle 9 1/2°

Given under my hand this 17th day of July
A.D. 1867

Joel Barber,
County Surveyor

per. James Wilson Jr.
Dept Surveyor

Recorded Aug. 17th 1867

I Joel Barber County Surveyor of Grant County Wis. do hereby certify that I have Surveyed Section 10 of Township 3 North of Range 1 East and have established the lines and corners as represented on the accompanying diagram, and that the distances and variations are correctly expressed on said diagram of Sec. 10

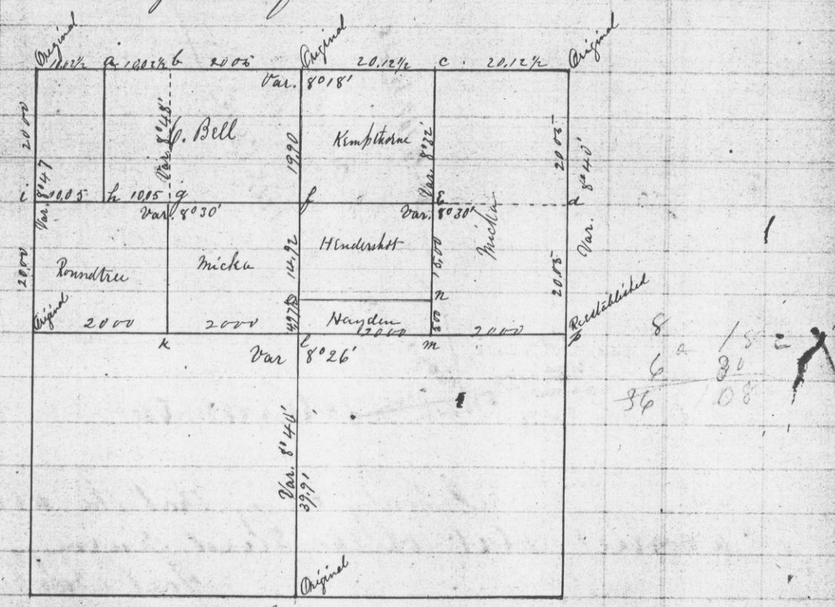
Original
Var. 8°18'
Kimpthorne
Bell
Hinderlitt
Micka
Hayden
Var. 8°30'
Var. 8°26'
Var. 8°44'
Var. 8°40'
