No 210

Plat and minutes of Survey in Section No 19 Town 3 Range 2 west of the Fourth Principal Meridian made June 4th 1869 To Wit:—

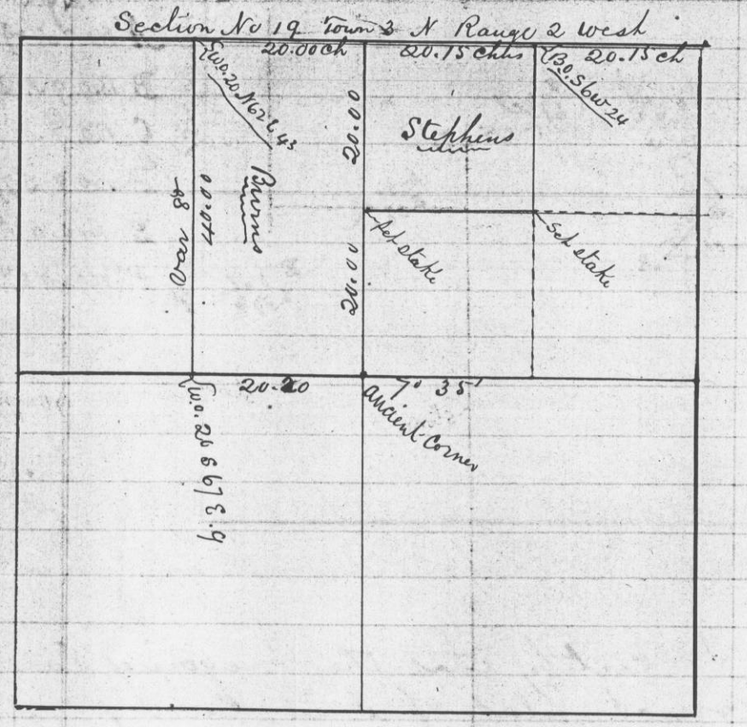

I certify that the foregoing is a correct plat of said Survey.

Joseph Allen
County Surveyor G. C. W.

No 211

Survey in the North West Quarter of the North East Quarter of Section No 36 Town 3 North Range 3 west of the Fourth Principal Meridian made the 5th day of June 1869. for F. Snieder as shown in the following plat To Wit:

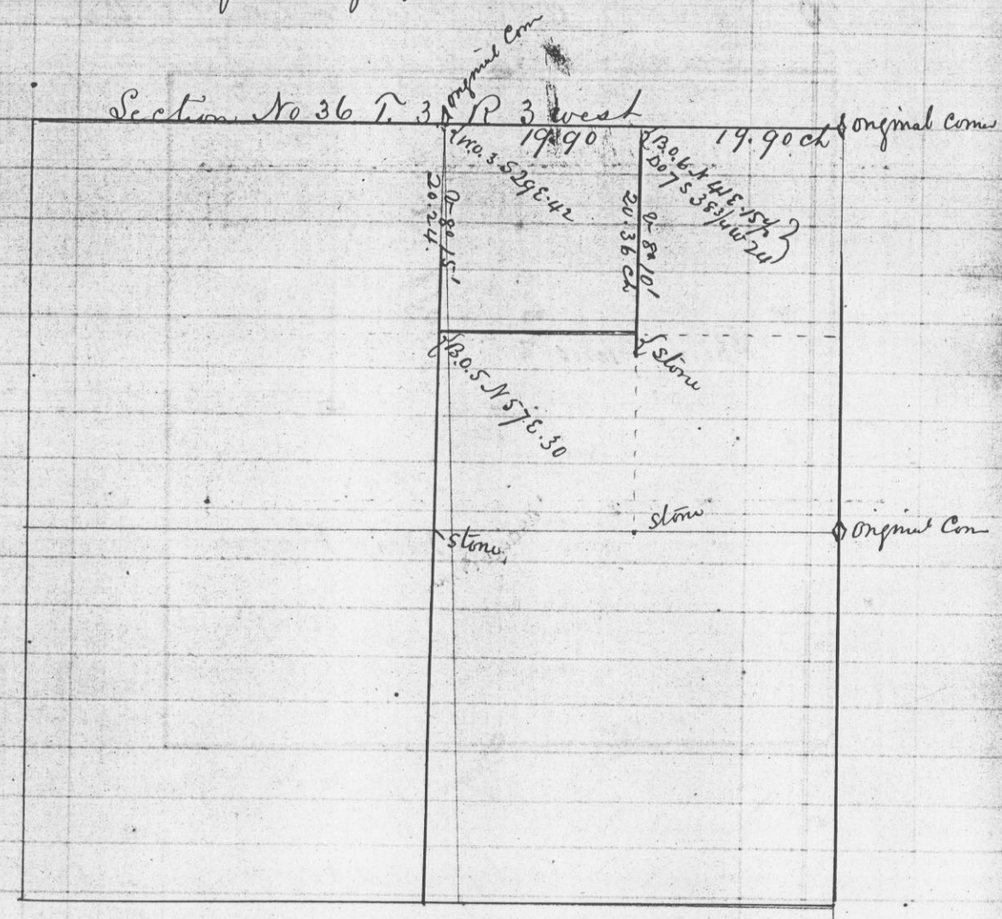

I certify that the foregoing is a correct plat of said Survey

Joseph Allen
County Surveyor.