No. 212

Survey made by order of Ayalon Wright administrator of Philip House in Section No twenty Town 6. Range one West of the Fourth Principal Meridian January 19th & 20th 1869 as shown in the following Plat, To wit.-

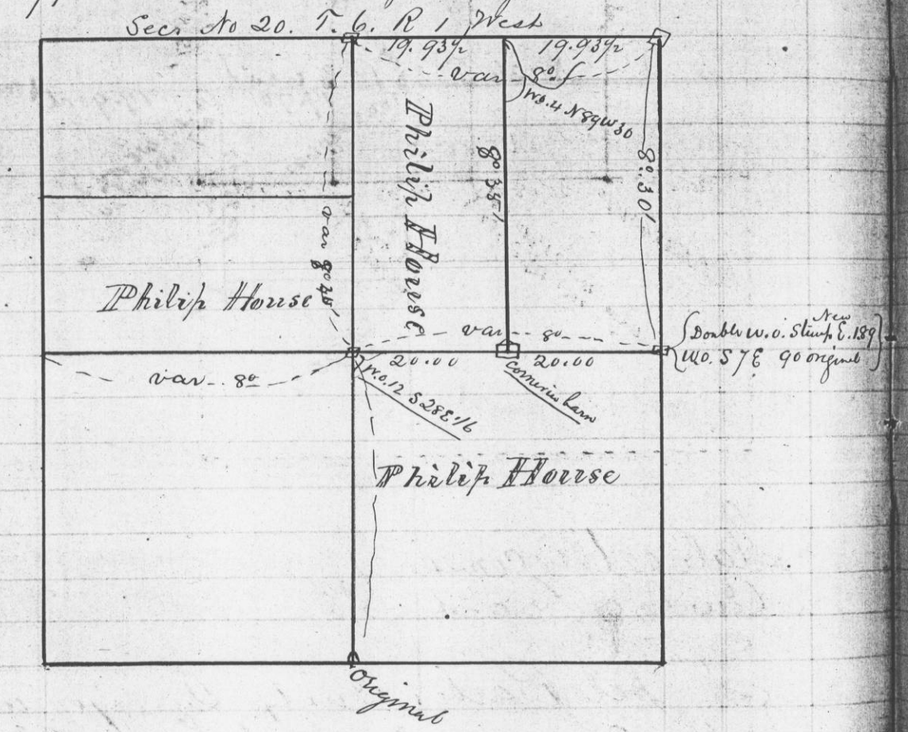

I hereby Certify that the foregoing Plat and minutes of Survey made by me the 19th and 20th of January 1869 are correct

Joseph Allen
County Surveyor

Section 29 Town 3. Range 4 West

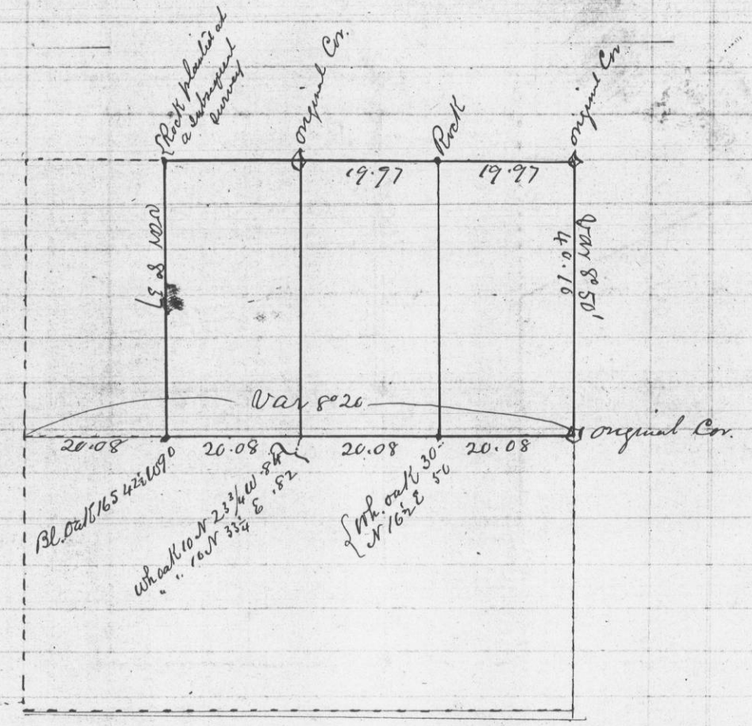

State of Wisconsin }
County of Grant } ss.

I Joel Barber County Surveyor in and for the aforesaid County do hereby Certify that I have surveyed Section No. 29 Town 3 Range 4 West as shown on the above map and that the above map is a correct representation of said survey

Given under my hand this 4th day of April 1868.

Joel Barber
County Surveyor
Per James Wilson Jr.