NO. 214

Section 15 & E½ of NE¼ of Section 16 Town 3 Range 5

215

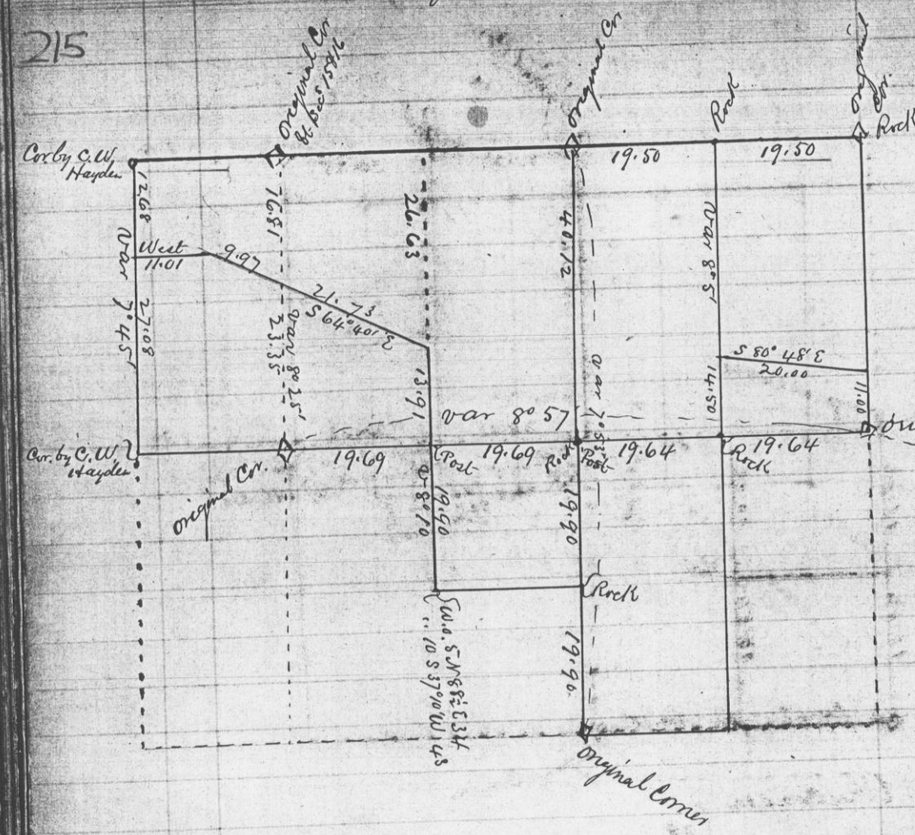

State of Wisconsin }
County of Grant } ss.

I Joel Barber Surveyor in and for the aforesaid County of Grant do hereby Certify that I have surveyed and established Sect. 15 and the E½ of the NE¼ of section No. 16 as represented on the above map and that the above map is a correct representation of said survey

Given under my hand this 7th day of July A.D. 1868

Joel Barber
Co Surveyor
Per James Wilson Jr
Dep Surveyor

(NO. 215)

Section No. 25 Town 3 Range 5 West

216

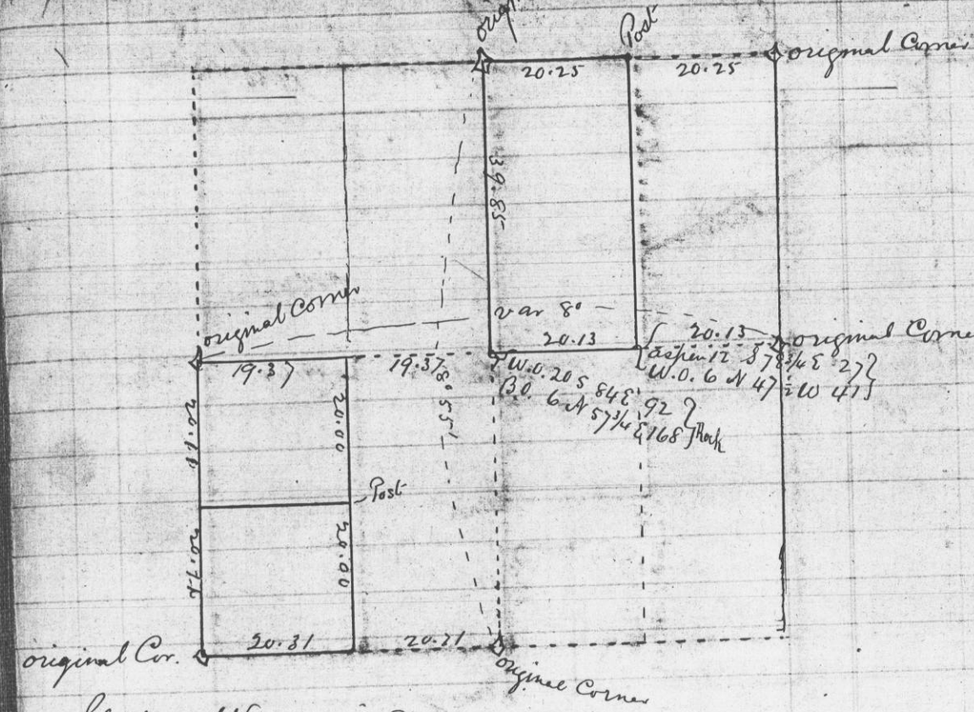

State of Wisconsin }
County of Grant } ss

I Joel Barber County Surveyor in and for the aforesaid County of Grant do hereby certify that I have surveyed and established the W½ of the NE¼ and the W½ of the SW¼ of Section No. 25 Town 3 Range 5 as shown on the above map. and that said map is a correct representation of said survey

Given under my hand this 3rd day of October A.D. 1867 & Dec. 30th 1868.

Joel Barber
County Surveyor
Per James Wilson Jr
Dep. Surveyor