(No. 230)

Plat and minutes of Survey in Section 27 Town 5 Range 2 West made the 26th day of May 1870

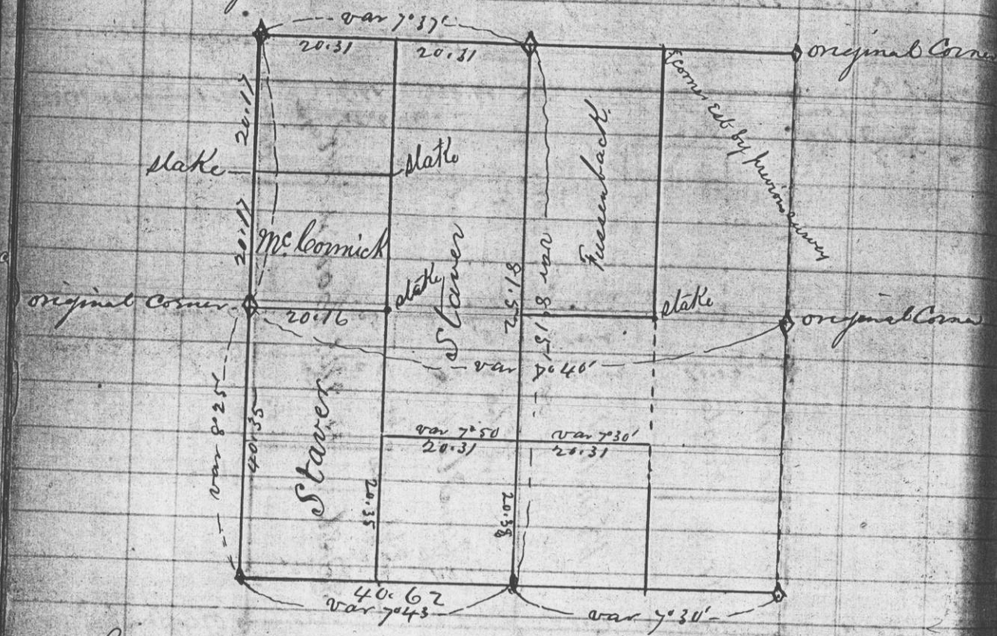

State of Wisconsin }
County of Grant } ss

I Joseph Allen County Surveyor in and for Grant County do hereby certify that I have surveyed and subdivided section 27 Town 5 Range 2 West as shown in the foregoing map. and that said map is a correct representation of said Survey

Given under my hand this 26th day of May 1870

Joseph Allen
County Surveyor

(No. 231)

Plat and minutes of Survey of the E½ of Section No. 28 Town 5 Range 2 West.

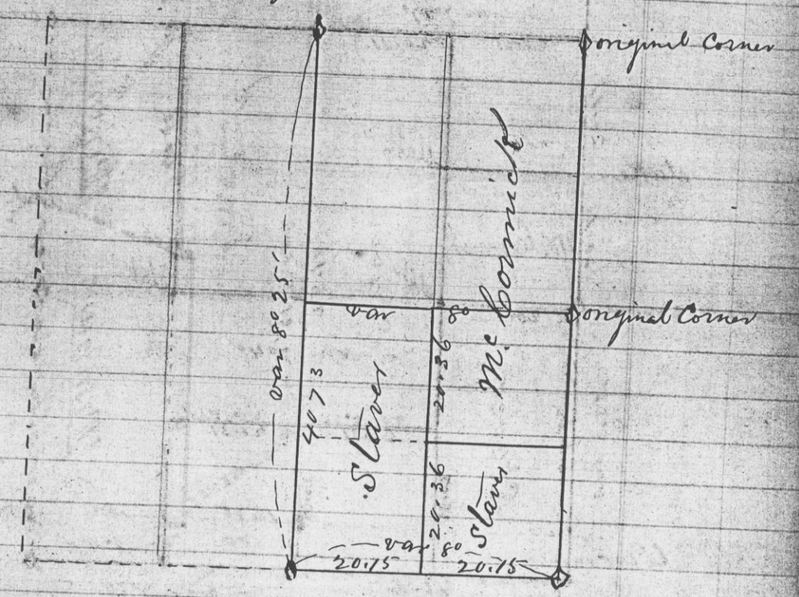

State of Wisconsin }
County of Grant } ss

I Joseph Allen County Surveyor in and for Grant County do hereby certify that I have surveyed the E½ of section No 28 Town 5 Range 2 as shown in the above map, and that said map is a correct representation of said survey

Given under my hand this 27th day of May 1870

Joseph Allen
County Surveyor