(No. 232)

Plat and Survey made in the E½ of Section No. 29. Town 6. Range 1.

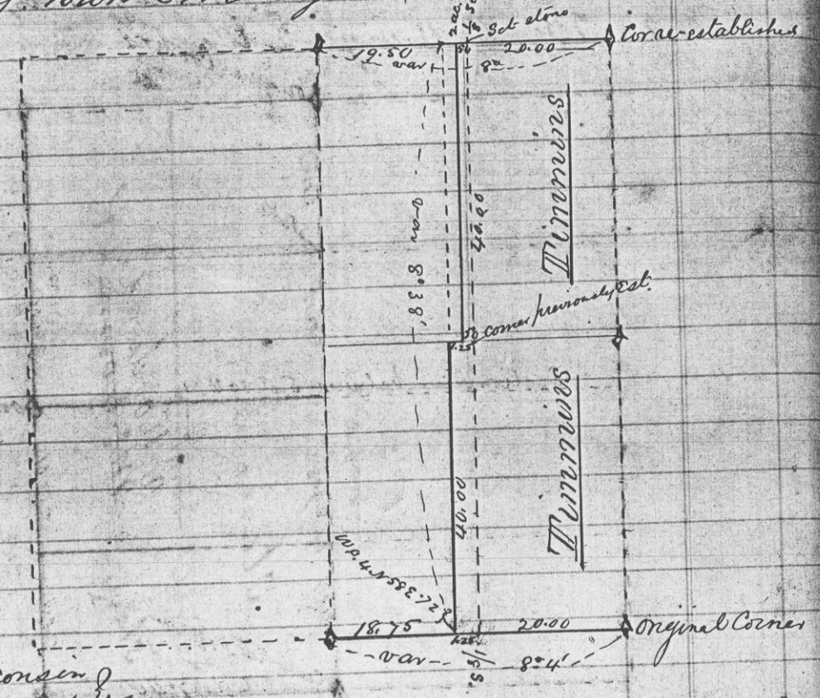

State of Wisconsin }
County of Grant } ss

I Joseph Allen County Surveyor in and for the aforesaid County do hereby certify that I have surveyed and established the division lines in the E½ of Section No 29 T. 6 Range 1 West as shown in the above map. The North East Corner of the section being lost I re-established it by placing it on the East line of Sects 20 & 29, and at the same distance South from the 2d Post on the East side of section 20 as the said 2d Post is South of the N.E. section Corner. D. Bartlo and Robert Gatty Chain duly sworn. And I further certify that the above map is a correct representation of said survey.

Given under my hand this 7th day of June 1870

Joseph Allen
County Surveyor

No 233

Sections 30 & 31 Town 6. Range 1 West

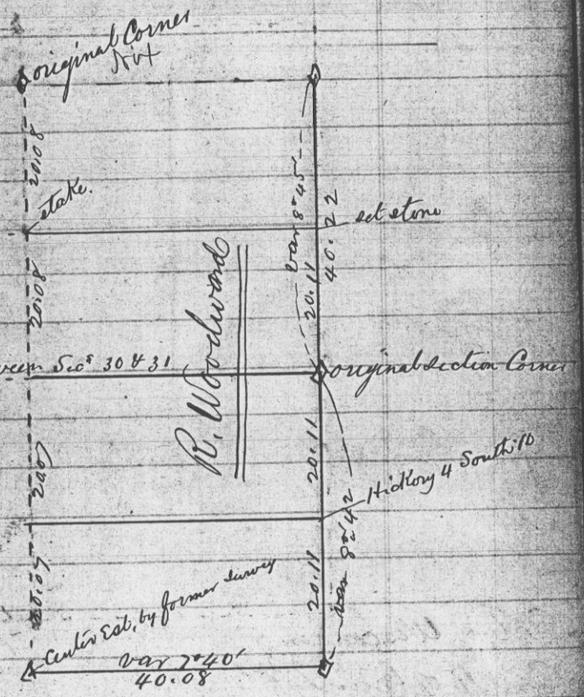

State of Wisconsin }
County of Grant } ss

I Joseph Allen County Surveyor in and for the aforesaid County do certify that I have surveyed and established the South East Quarter of Section 30 and the North East Quarter of Section No 31 T. 6 R. 1 W. as shown in the above map and that the said map is a correct representation of said survey. Given under my hand this 19th day of Oct 1870

Joseph Allen
County Surveyor.