(No. 236)

Survey of Mill Dam and Head race in the S W¼ of S E¼ of Section 28 T. 4 R. 2.

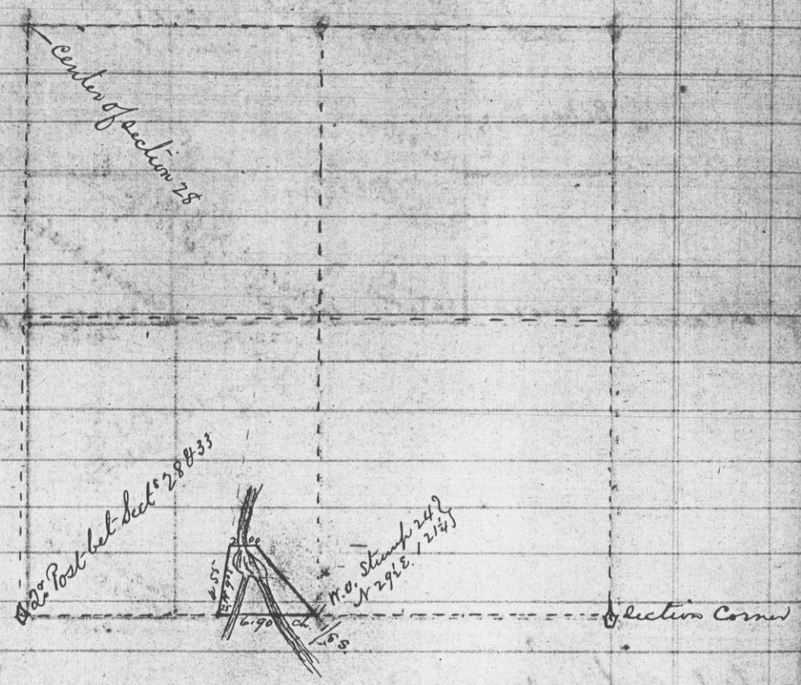

Commencing on the Section Line between Sect 28 & 33 twenty five links west of the West edge of the Mill race and running North 9° East 4.55 chns thence East across Platte 2 chains thence S. 47° E. to ⅛ Section Corner thence West 6.90 chains to place of beginning containing 2 acres.

Surveyed Nov 18th 1870

Attest:

Joseph Allen
County Surveyor

(No. 237)

Section 19 T4 R. 2

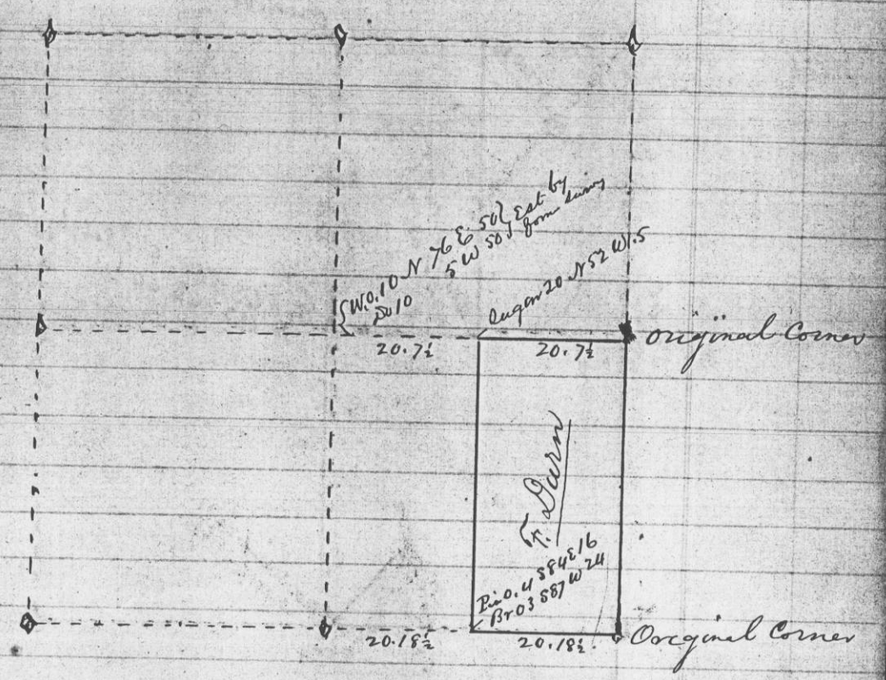

State of Wisconsin
County of Grant } ss.

I Joseph Allen County Surveyor in and for Grant County do hereby certify that I have surveyed and established the E½ of the S E¼ of Section No. 19 T. 4 R 2. as shown in the above map and that said map is a correct representation of said survey.

Given under my hand this 24th day of Nov 1870

Joseph Allen
County Surveyor