No 240

Section 12 Town 5 Range 2 West.
Surveyed Dec. 1st 1870
Fred. Fritz and Henry Rowland Chauman sworn

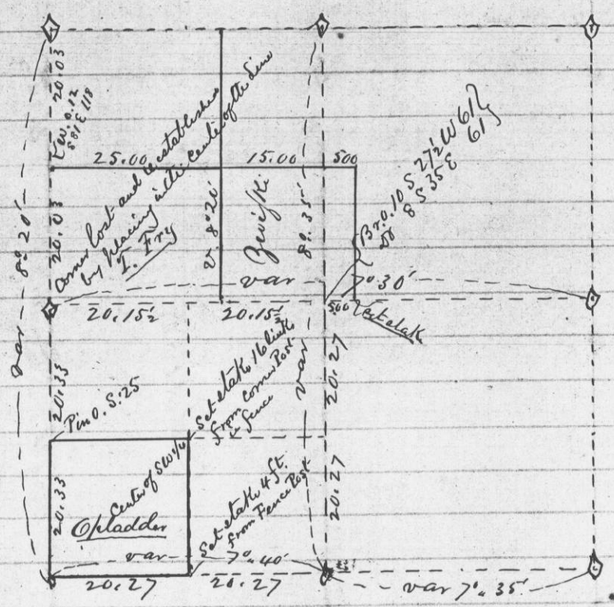

State of Wisconsin }
County of Grant } ss.

I Joseph Allen County Surveyor in and for the aforesaid County do hereby certify that I have surveyed and subdivided the SW¼ of Section No 12 T. 5 R 2 as shown in above map and that said map is a correct representation of said Survey Given under my hand this 1st day of December 1870

Joseph Allen
County Surveyor.

(No 241)

Section 35 T 7 N of R 1 W

Survey for Winfield Huterba parts of section 35 of Town 7 North of Range 1 West June 20th 1874 as per law made and provided.
Stones are set at the corners designated and described in the margin of the plat designating the survey to wit;

Reference

at 1 Sandstone 30 in long 12 wide and 8 thick
at 2 Lime 26 X 8 X 4.
at 3 Sand 28 X 14 X 8
at 4 Lime 16 X 12 X 4

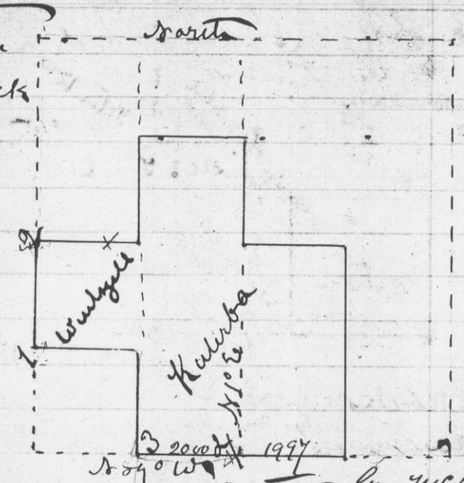

attest Geo McFall
Co Surveyor
by C B Overlee
Dep Co Surveyor
Grant Co Wisc