252

Survey made for Duckworth Finerty, Wyman Tohl Eenhard Vasburg &c of section 20 T 1 R 1 west Aug 9th 1872 as shown in the following plat and field notes

Sec 20 T1R1 Von 9th

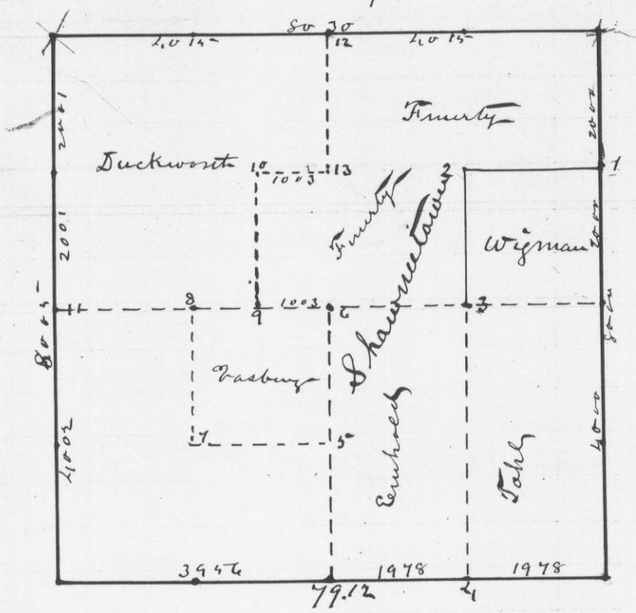

Reference

at 13 Willow 12 inches S 52° E 219 links
" 12 Cottonwood 20 A N 74 E 157 "
" 11 Do 30 N 78° 30' W 602 "
" 1 Stone 4 X 8 X 10 inches
" 6 center of section ascertained as per statute made and provided

all other corners are marked with magnesian Lime stone of nearly uniform size at at such places and distances as are indicated on the above plat

attest Geo McFall
County Surveyor

253

Survey made for Wm Dilve of the SE¼ of NE¼ of Sec 28 T 3 N of R 3 West June 10th 1872 as shown in the following plat and field notes

Sec 28 T3R3

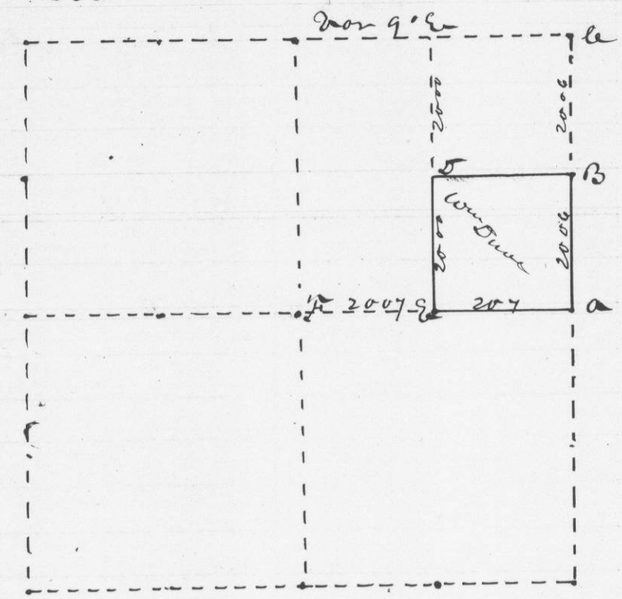

at a original corner found
at B set equal distant from a the W 9 S 30 E 44 links
" E set " " " a G E Bo 8 N 84½ W 118 "
" D Bo 22 inches S 41 W 31 links

attest
Geo McFall
County Surveyor