2 2.

Section 4 Township 4 North Range 3 West of 4th P. M

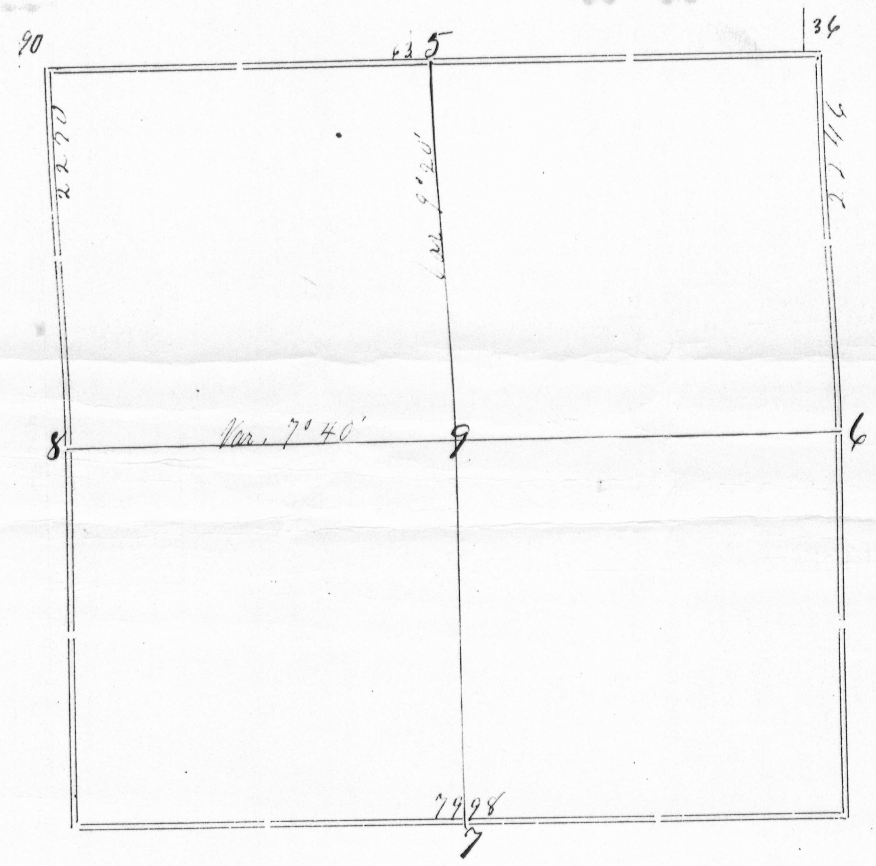

Corners	Bearing Trees	In. Dia.	Courses they Bear	Links Distant	REMARKS
5	Stake without		Bearings		This corner is Established 63 links East of the Govt. quarter corner set for Sec. 33 Town 5 R 3 West.
6	Stone corner		previously set		Original Bearings extant and correct
7	White Oak Blk. Oak	8 10	N 3 2½ E N 48 W	15 24½	These are new bearings in place of the old ones which are destroyed
8	White Oak Pin Oak	7 4	N 83½ E S 69 E	35 3½	New bearings to the Orginal Govt cor.
9	White Oak Hickory	6 13	S 70½ E S 78 W	144 257	

CERTIFICATE OF SURVEY.

STATE OF WISCONSIN, } ss.
GRANT COUNTY,

I, Joel Barker, County Surveyor in and for the County and State aforesaid, do hereby certify that I have executed the Survey represented by the foregoing Plat and annexed Field Notes of Survey, in accordance with the State Laws and Instructions of the Commissioner of the General Land Office. Scale, 80 chains to 4 inches. The figures in red ink are the lengths of the lines as stated in the Field Notes of the Government Survey.

Declination of the Magnetic Meridian from the True Meridian ..... East. The variation of needle adopted in establishing corners is 8° 30' East.

WITNESS my hand this 26th day of December A. D. 1876