Section 5 Township 2 North Range 2 West of 4th P. M. 5

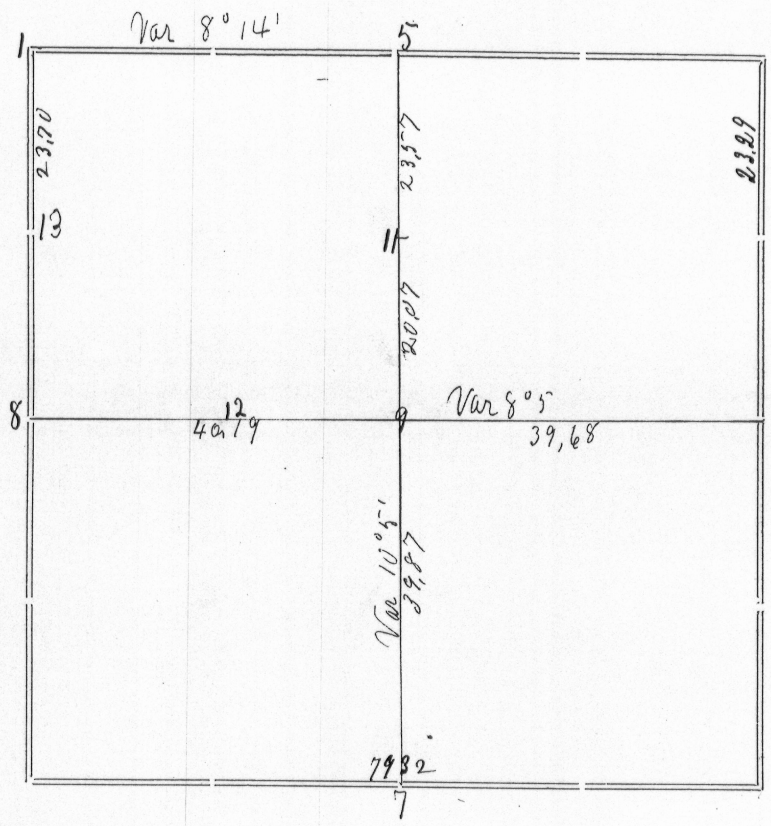

Corners	Bearing Trees	In. Dia.	Courses they Bear	Links Distant	REMARKS
1	Br Oak	3	N 38½ E	11	New
5	Br Oak	13	S 7 W	15	New
7	White Oak Red "	26 5	S 28½ W S 20 E	46 25	New bearings
8	White Oak Red Oak	3 4	S 73½ E S 59 W	17 20	New bearings
9	White Oak Br Oak	26 8	N 59½ W S 58 E	91 76	
11	White Oak Blk Oak	24 8	N 17½ E N 81¼ W	102½ 41½	
12	Red Oak W Oak	8 10	S 47 W S 9½ E	32½ 89½	

CERTIFICATE OF SURVEY.

STATE OF WISCONSIN, } ss.
GRANT COUNTY,

I, Joel Barber, County Surveyor in and for the County and State aforesaid, do hereby certify that I have executed the Survey represented by the foregoing Plat and annexed Field Notes of Survey, in accordance with the State Laws and Instructions of the Commissioner of the General Land Office. Scale, 80 chains to 4 inches. The figures in red ink are the lengths of the lines as stated in the Field Notes of the Government Survey.

Declination of the Magnetic Meridian from the True Meridian ..... East. The variation of needle adopted in establishing corners is 8° 30' East.

WITNESS my hand this 26th day of December A. D. 1876

Jacob Shilters
Joseph Scholl } CHAINMEN.

Joel Barber SURVEYOR.