Section 4 Township 4 North Range 3 West of 4th P. M. 7

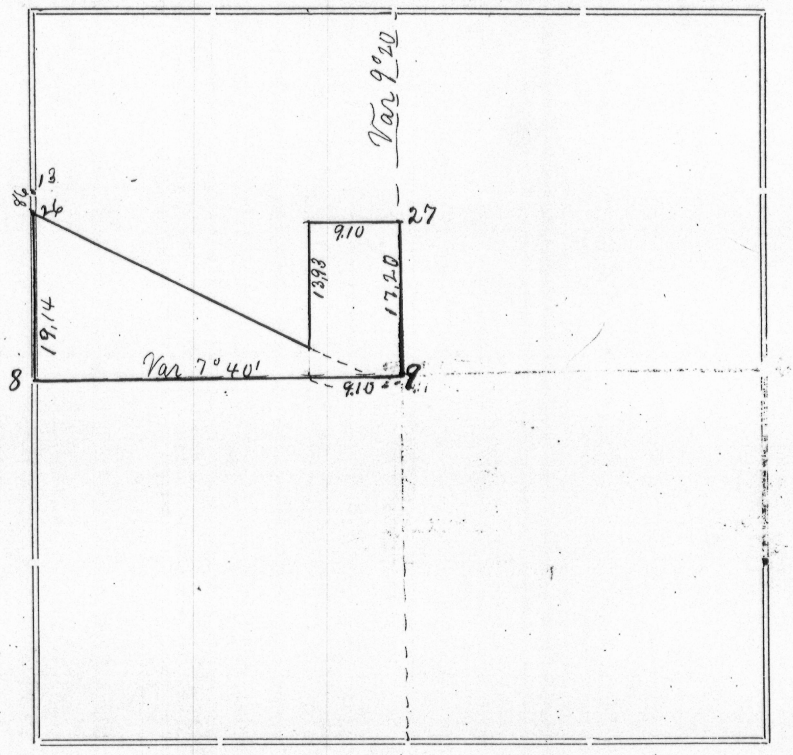

Corners	Bearing Trees	In. Dia.	Courses they Bear	Links Distant	REMARKS
8	White Oak Pin Oak	7 4	N 28½ E S 69 E	25 3½	New Bearings in place of Original
9	White Oak Hickory	6 13	S 70½ E S 78 W	144 257	
26	No permanent	Corner made			86 links South of Corner 13 and on Section line
27	Corner on quarter Section line and 1720 links North of legal centre of Sec. 4.				

STATE OF WISCONSIN, } ss.
GRANT COUNTY,

CERTIFICATE OF SURVEY.

I, Joel Barbus, County Surveyor in and for the County and State aforesaid, do hereby certify that I have executed the Survey represented by the foregoing Plat and annexed Field Notes of Survey, in accordance with the State Laws and Instructions of the Commissioner of the General Land Office. Scale, 80 chains to 4 inches. The figures in red ink are the lengths of the lines as stated in the Field Notes of the Government Survey.

Declination of the Magnetic Meridian from the True Meridian ..... East. The variation of needle adopted in establishing corners is 8° 30 East.

WITNESS my hand this 9th day of January A. D. 1877 Surveyed Feb. 19th 1876

..... } CHAINMEN.

Joel Barbus SURVEYOR.