Section 3 Township 5 North Range 1 West of 4th P. M. 9

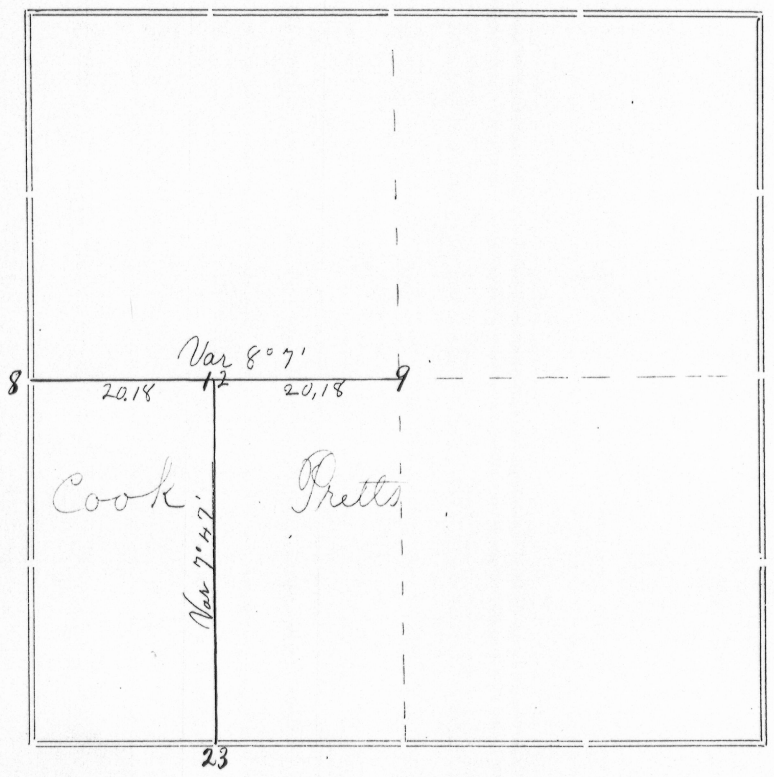

Corners	Bearing Trees	In. Dia.	Courses they Bear	Links Distant	REMARKS
8	Burr Oak Burr Oak	8 3	S 21½ W S 20 E	144 74	Corner established from reliable traces of the original bearings
9	Corner set by		Geo. R. Stuntz — old	stake — no bearings — authenticity unquestioned.	
12	White Oak	4	N 25½ W	50	Aspen 3 marked with marking iron for corner
23	Stone corner set by		Geo. R. Stuntz		

Surveyed for Levi Pretts
Apr. 29th 1876

CERTIFICATE OF SURVEY.

STATE OF WISCONSIN, GRANT COUNTY, } ss.

I, Joel Barber, County Surveyor in and for the County and State aforesaid, do hereby certify that I have executed the Survey represented by the foregoing Plat and annexed Field Notes of Survey, in accordance with the State Laws and Instructions of the Commissioner of the General Land Office. Scale, 80 chains to 4 inches. The figures in red ink are the lengths of the lines as stated in the Field Notes of the Government Survey.

Declination of the Magnetic Meridian from the True Meridian ..... East. The variation of needle adopted in establishing corners is 8° 30' East.

WITNESS my hand this 12th day of January A. D. 1877.

Robert J. Dewar
Geo. W. Kendrick } Chainmen.

Joel Barber Surveyor.