Section 30 Township 3 North Range 1 West of 4th P. M.

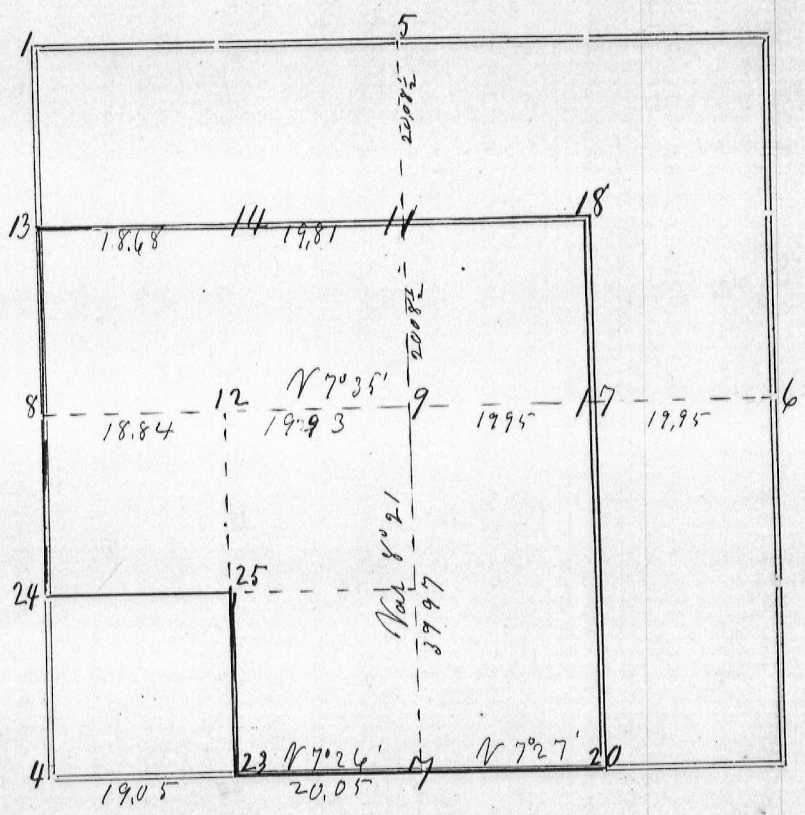

Corners	Bearing Trees	In. Dia.	Courses they Bear	Links Distant	REMARKS
1	Burr Oak White Oak	28 8	North S 78½ W	310 55	Established from Stumps of bearing trees the Harrison corner 1.00 South The rock formerly set is not correct
4					Fully identified
5	Elm	36	N 87 W	51½	New — Old bearings dead — stone at corner
6					N. W. original bearings in good order
7					Both original bearings in good order
8	White Oak " "	22 28	N 44½ W North	22 46	Set Corner 92½ links north of established corner on east side Sec. 25 T 3 N R 2 E
9	Double R Oak White Oak	12 10	N 49 E N 46 W	17 49	
11	R Oak B Cherry	12 7	S 9¼ E S 50 W	40 40	Surveyed for Wm. Robinson Apr. 10-11-12th 1877
12	W Oak Lynn	30 12	N 64½ E N 46¾ W	85½ 117	
13	W Oak 8 W Oak	20 7	S 59½ E N 7½ W	54 30	
14	W Oak Black Cherry	10 8	S 46 E S 10¼ W	56 85	This corner was set by measurement of the line from No. 11 to No. 13
17	W Oak W Oak	6 28	S 63 W N 37½ W	47 37	
20	Previously	established			Made a mound of stones
23	White Oak	10	N 10¼ E	101	W C 12 S 88 E 20
24	White Oak	12	N 73 E	79	R C 12 N 6½ E 80
25	White Oak	24	N 31 E	30	W C 20 S 34 W 82

CERTIFICATE OF SURVEY.

STATE OF WISCONSIN, GRANT COUNTY, } ss.

I, Joel Barber, County Surveyor in and for the County and State aforesaid, do hereby certify that I have executed the Survey represented by the foregoing Plat and annexed Field Notes of Survey, in accordance with the State Laws and Instructions of the Commissioner of the General Land Office. Scale, 80 chains to 4 inches. The figures in red ink are the lengths of the lines as stated in the Field Notes of the Government Survey.

Declination of the Magnetic Meridian from the True Meridian ..... East. The variation of needle adopted in establishing corners is 8° 30' East.

WITNESS my hand this 17 day of April A. D. 1877

John Lonkhans } Chainmen.
John P. Holmes }

Joel Barber Surveyor.