Section 22 Township 5 North Range 5 West of 4th P. M.

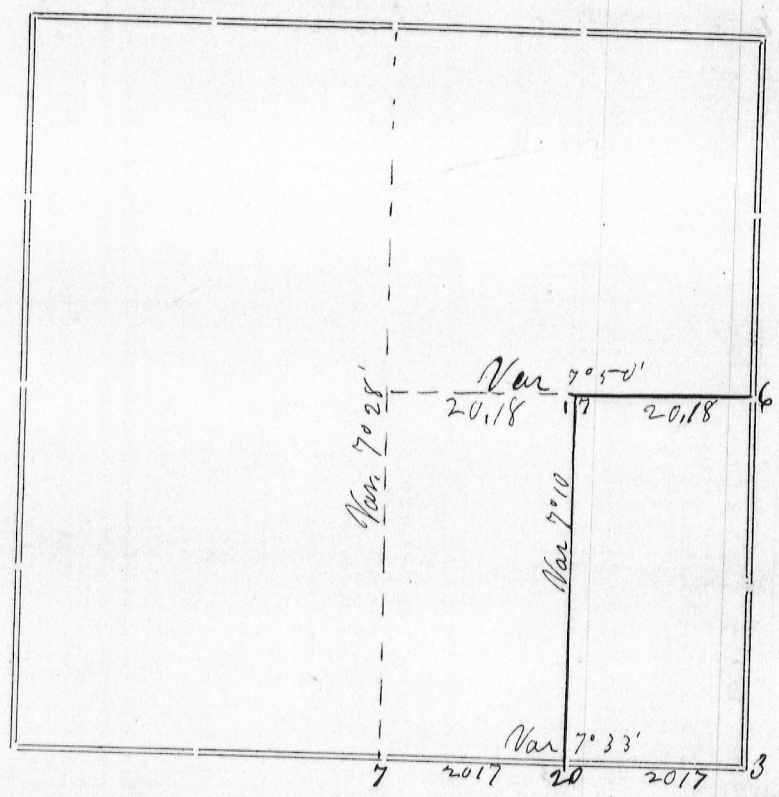

Corners	Bearing Trees	In. Dia.	Courses they Bear	Links Distant	REMARKS
3	Stone corner		found		
6	Found stone		corner	and	original bearings agreeing
7	SW Corner of house Corner fence post		N 55½ E S 34 W	182 113½	The position of this corner was determined by evidence of former excavation in same place
17	Black Oak Black Oak	20 14	N 37½ W East	7 9	
20	Set corner		Equidistant		without bearing,

Surveyed for Samuel Parker

STATE OF WISCONSIN, GRANT COUNTY, } ss.

CERTIFICATE OF SURVEY.

I, Joel Barber, County Surveyor in and for the County and State aforesaid, do hereby certify that I have executed the Survey represented by the foregoing Plat and annexed Field Notes of Survey, in accordance with the State Laws and Instructions of the Commissioner of the General Land Office. Scale, 80 chains to 4 inches. The figures in red ink are the lengths of the lines as stated in the Field Notes of the Government Survey.

Declination of the Magnetic Meridian from the True Meridian ..... East. The variation of needle adopted in establishing corners is 8° 30' East.

WITNESS my hand this 26th day of June A. D. 1878

Nathl Austin
Leroy Hudson } CHAINMEN.

Joel Barber SURVEYOR.