Township 1 North Range 2 West of 4th P. M.

32

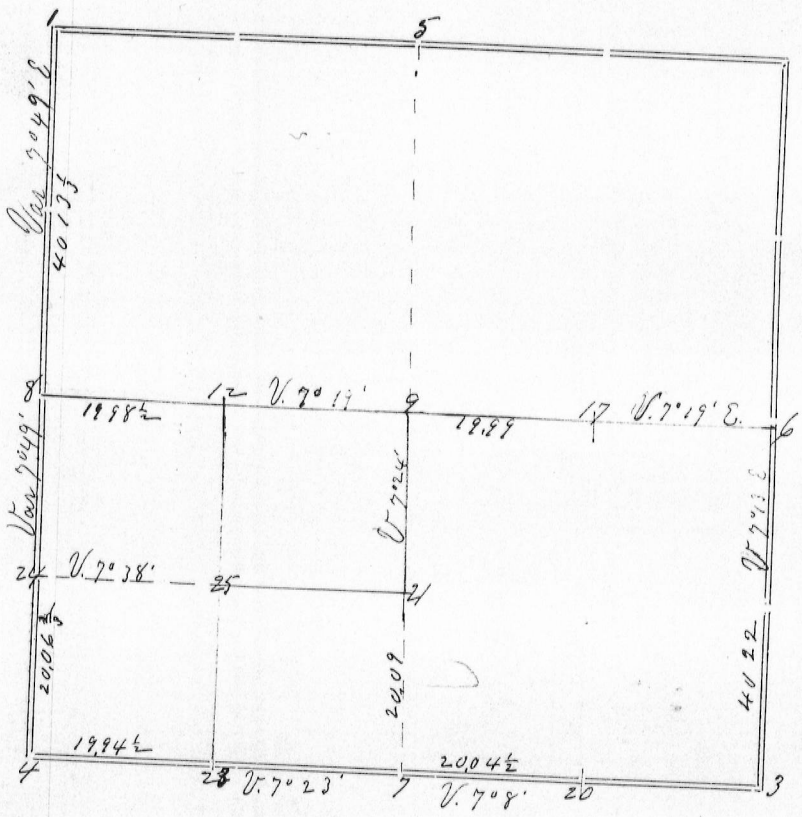

Corners	Bearing Trees	In. Dia.	Courses they Bear	Links Distant	REMARKS
3	Br Oak " " Br Oak 4 S 30 E 68	11 6 Br Oak	S 7¾ W N 12¾ W 7 N 54¼ E	62 53 118	Found by measurement to ¼ Secs. corners North + South of it. Easting and walking judged from best evidence of old fences,
4	N.W. corner of Brick House Black Oak	10	S 53¼ E South	78 23	Found by measurement to nearest authentic Govt. corners which were one half mile East South + West and one mile North.
5	Stone set by myself in former survey				
6	Br Oak Br Oak	7 3	S 46½ W N 87 W	54 24½	Original mound still distinguishable and was tested by measurement of the whole Section line
7	Cedar Stake with one original bearing				
8	Ashen Hickory	7 12	S 63 E S 7¾ W	62 326	Discredited corner stone N 22 7/8° E 30
9	Set stake	Without bearings			
12	Br Oak Br Oak	10 10	S 49½ W S 18½ E	47 30½	
17	Set Stake		No bearings		
20	Set stake		No bearings		
23	Br Oak Pin Oak	8 6	N 51 E N 37½ W	153 84	Surveyed for Mrs. Weidenhoft and Frank Dratzel Aug 13th 1878 certificate issued Sept 2nd 1878
24	Black Oak	5	N 22½ E	86	
25	Br Oak Br Oak	10 7	N 84½ E S 40 E	21 58½	No other tree near

STATE OF WISCONSIN, }
GRANT COUNTY, } ss.

CERTIFICATE OF SURVEY.

I, Joel Barber, County Surveyor in and for the County and State aforesaid, do hereby certify that I have executed the Survey represented by the foregoing Plat and annexed Field Notes of Survey, in accordance with the State Laws and Instructions of the Commissioner of the General Land Office. Scale, 80 chains to 4 inches. The figures in red ink are the lengths of the lines as stated in the Field Notes of the Government Survey.

Declination of the Magnetic Meridian from the True Meridian ..... East. The variation of needle adopted in establishing corners is 8° 38' East.

WITNESS my hand this 2nd day of September A. D. 1878.

Joseph Long
Charles Aurelin } CHAINMEN.

Joel Barber
Surveyor