Section 3 Township 5 North Range 2 West of 4TH P. M.

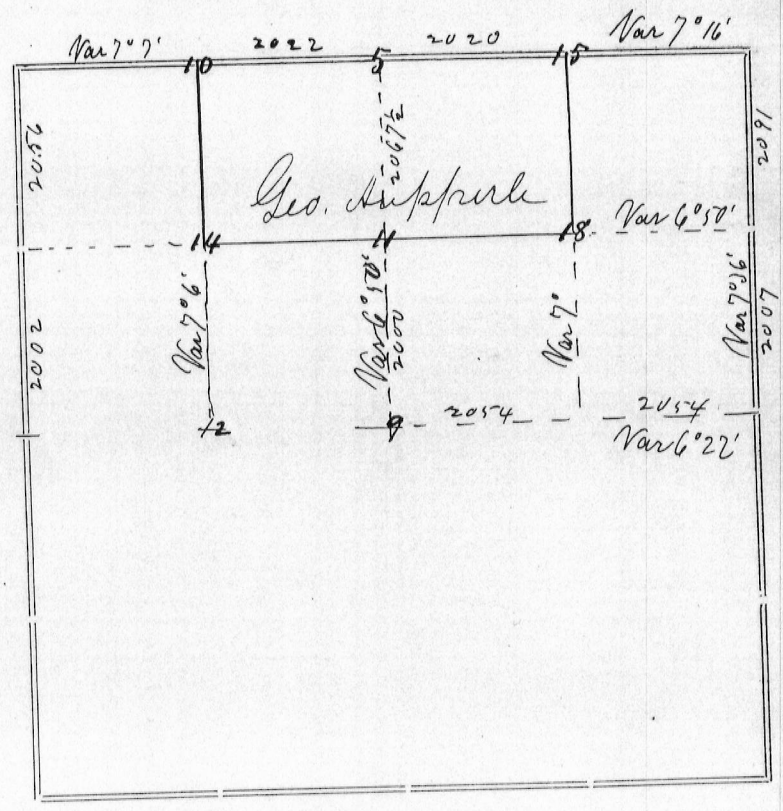

Corners	Bearing Trees	In. Dia.	Courses they Bear	Links Distant	REMARKS
5	Br Oak Br Oak	4 4	N 81½ E N 80 W	12 5	Placed 17½ links west of ¼ post South of Sec. 34-6-2 of which both bearings are in good condition.
9	White Oak	28	Said to be the corner tree, treated if as such in this survey -		
	Many old marks on the tree - one on north side looked like old bearing tree mark				
10	Bi Oak Br Oak	7 10	N 60 E S 33 E	23 131	
11	Br Oak Black Oak	10 13	S 83¼ E S 5-4 W	101 116	
12	Ancient corner stake				not tested
14	White Oak White Oak	18 14	S 80 E N 33 E	48 5-3½	
18	Br Oak Red Oak	— 7	N 15 ¾ E N 5-3½ W	169 171½	
15	Ancient corner Stone Found			correct	

Surveyed for Geo. Stilpsure
Sept 16 & 17 1879

CERTIFICATE OF SURVEY.

STATE OF WISCONSIN, GRANT COUNTY, } ss.

I, Joel Barber, County Surveyor in and for the County and State aforesaid, do hereby certify that I have executed the Survey represented by the foregoing Plat and annexed Field Notes of Survey, in accordance with the State Laws and Instructions of the Commissioner of the General Land Office. Scale, 80 chains to 4 inches. The figures in red ink are the lengths of the lines as stated in the Field Notes of the Government Survey.

Declination of the Magnetic Meridian from the True Meridian ..... East. The variation of needle adopted in establishing corners is 8° 30' East.

WITNESS my hand this 30th day of September A. D. 18 79

Louis Stilpsich
Herman W. Remmert } Chainmen.

Joel Barber Surveyor.