Section 4 Township 7 North Range 1 West of 4th. P.M.

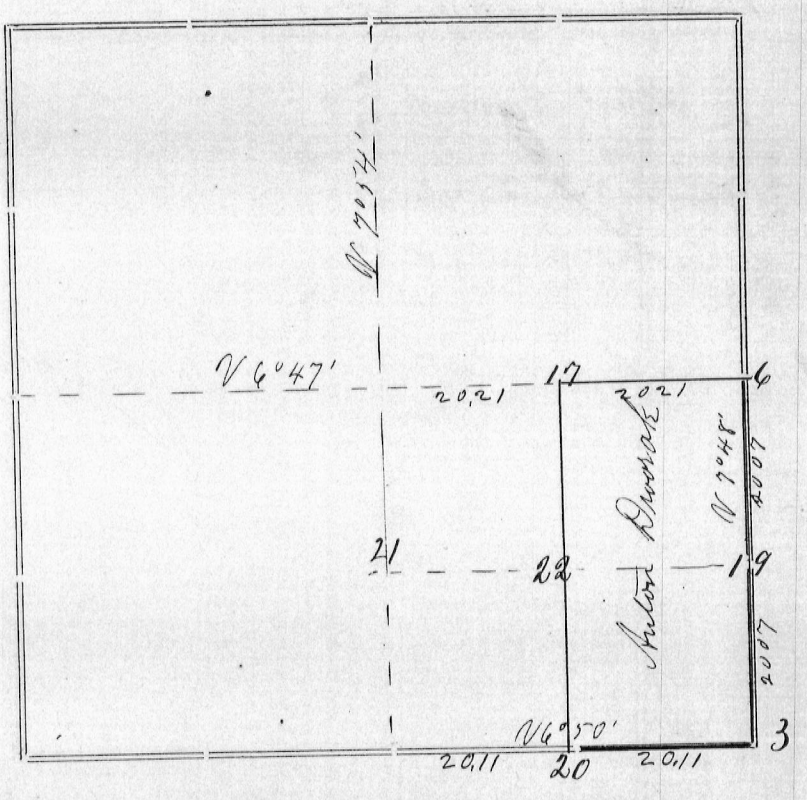

Corners	Bearing Trees	In. Dia.	Courses they Bear	Links Distant	REMARKS
3	White Oak Black Oak	13 16	East S 87 W	34 148	See No. 4 page 54 Book D
6	Hickory Br Oak	8 10	S 17½ E S 76 E	181 40	See No. 8 page 54
17	Br Oak " "	7 6	N 10½ E S 74½ W	37 11	
19	Pin Oak Black Oak	8 14	S 46⅔ W N 19¾ E	80 166½	See No. 24 Page 54
20	Br. Oak " corner Stone	20 4 Old	N 49 E S 86½ W S 39½ W	59½ 43 7½	
21	Not established				
22	Double Elm Br Oak	24 6	S 84 E S 69½ W	225 141	
					Surveyed for Anton Gwosak Feb 1880

CERTIFICATE OF SURVEY.

STATE OF WISCONSIN, } ss.
GRANT COUNTY, }

I, Joel Barber, County Surveyor in and for the County and State aforesaid, do hereby certify that I have executed the Survey represented by the foregoing Plat and annexed Field Notes of Survey, in accordance with the State Laws and Instructions of the Commissioner of the General Land Office. Scale, 80 chains to 4 inches. The figures in red ink are the lengths of the lines as stated in the Field Notes of the Government Survey.

Declination of the Magnetic Meridian from the True Meridian ..... East. The variation of needle adopted in establishing corners is 8° 30' East.

WITNESS my hand this Eighth day of March A. D. 1880

Albert Chrecht } Chainmen.
Jacob Gadzagl }

Joel Barber Surveyor.