Section 25 Township 3 North Range 5 West of 4th P. M.

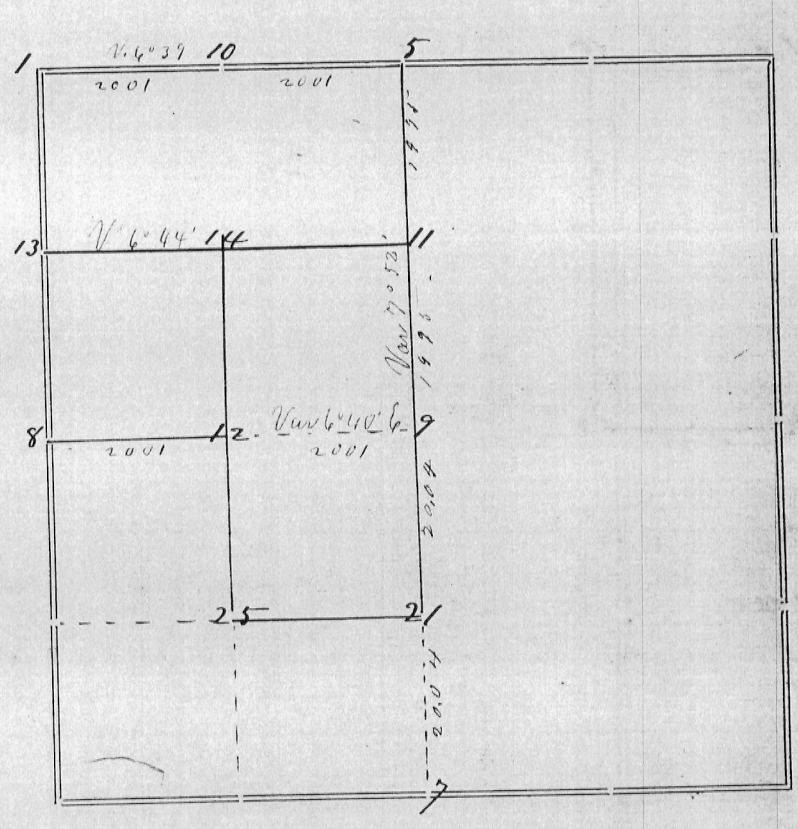

Corners	Bearing Trees	In. Dia.	Courses they Bear	Links Distant	REMARKS
1	Set rock	at old corner			
5	Old corner	stone found			
7	Original - Govt	Corner			The Br Oak bearing in good order
8	Stone heap	established by	James Wilson		
9	Set rock	at Wilsons	corner		
10	Set stone Cottonwood	for 14	corner North	8	
11	Br Oak Br Oak	6 8	N 27 7/5 W S 64 4 E	96 160	Old disputed corner stand 47 links west
12	Set rock	for corner			
13	Set stake	by measure	equidistant	148	
14	Set rock	32 x 12 x 5			
21	Rock	30 x 12 x 5			
25	Rock	22 x 11 x 5			
					Surveyed Fair George Grom & A. De Hart
					Sept. 6th & 7th 1880

CERTIFICATE OF SURVEY.

STATE OF WISCONSIN, } ss.
GRANT COUNTY,

I, Joel Barber, County Surveyor in and for the County and State aforesaid, do hereby certify that I have executed the Survey represented by the foregoing Plat and annexed Field Notes of Survey, in accordance with the State Laws and Instructions of the Commissioner of the General Land Office. Scale, 80 chains to 4 inches. The figures in red ink are the lengths of the lines as stated in the Field Notes of the Government Survey.

Declination of the Magnetic Meridian from the True Meridian ..... East. The variation of needle adopted in establishing corners is 8° 30' East.

WITNESS my hand this 18th day of September A. D. 1880

William M. Barnes
John L. Eversoll } CHAINMEN.

Joel Barber SURVEYOR.