Section 3 Township one North Range two West of 4th P. M.

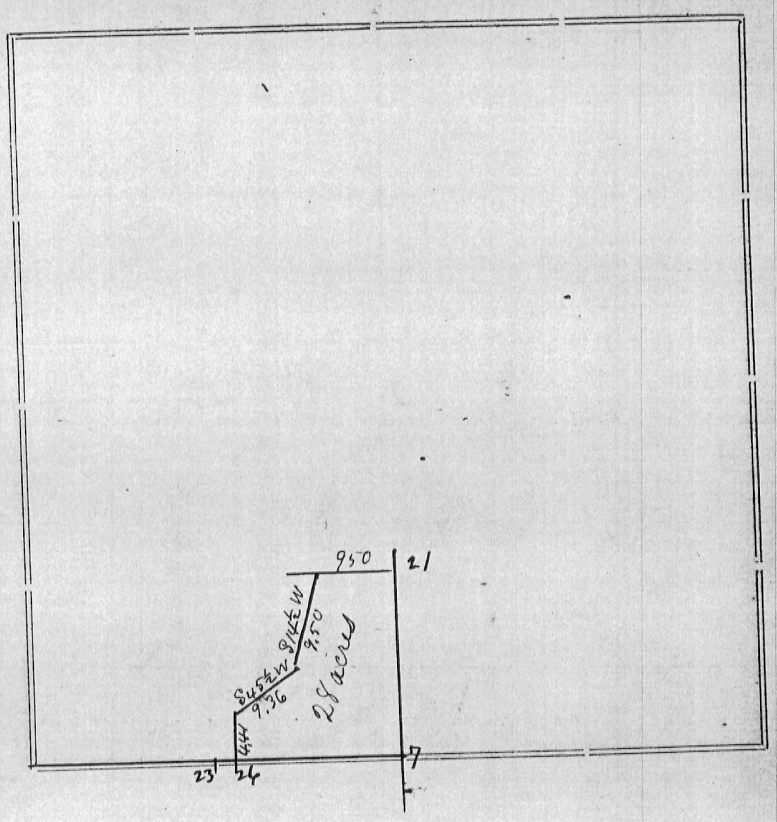

Corners	Bearing Trees	In. Dia.	Courses they Bear	Links Distant	REMARKS
7	Burr Oak Black Oak	6 10	N 58 E N 57½ W	30 44½	Bar post is the traditional corner
21	Ancient corner		Stone		
23	Set corner		Stone		
26	Set corner		Stone 185 East of 23		

Surveyed Oct. 8th 1880
For David Weigel

CERTIFICATE OF SURVEY.

STATE OF WISCONSIN, } ss.
GRANT COUNTY, }

I, Joel C Barber, County Surveyor in and for the County and State aforesaid, do hereby certify that I have executed the Survey represented by the foregoing Plat and annexed Field Notes of Survey, in accordance with the State Laws and Instructions of the Commissioner of the General Land Office. Scale, 80 chains to 4 inches. The figures in red ink are the lengths of the lines as stated in the Field Notes of the Government Survey.

Declination of the Magnetic Meridian from the True Meridian ..... East. The variation of needle adopted in establishing corners is 8° 31' East.

WITNESS my hand this 8th day of November A. D. 1880

..... } Chainmen.

..... Joel C Barber Surveyor.