Section 23 Township 3 North Range 3 West of 4th P.

84

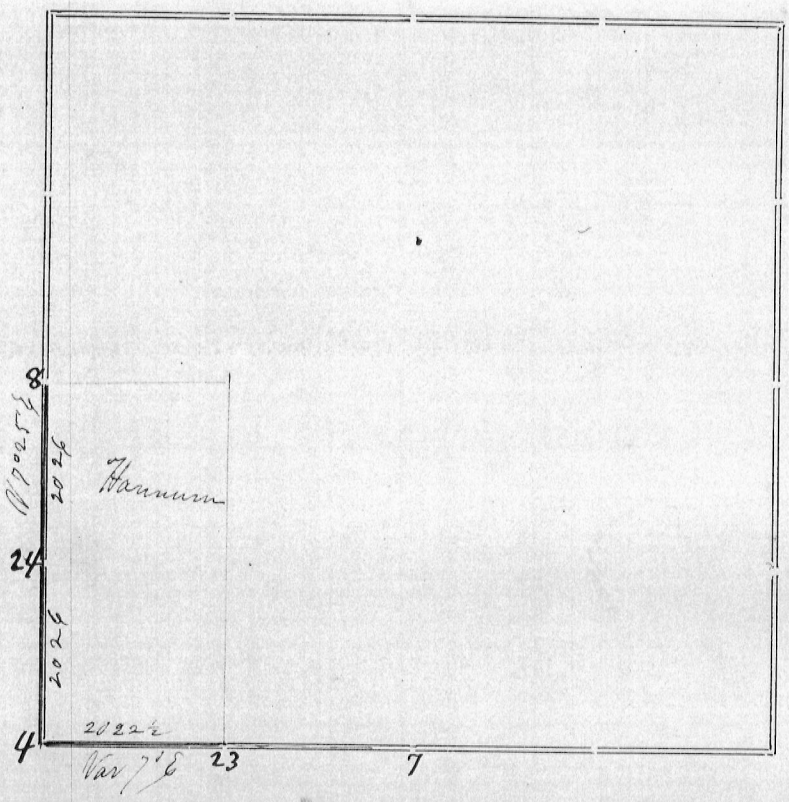

Corners	Bearing Trees	In. Dia.	Courses they Bear	Links Distant	REMARKS
4	Set Stone for Section corner by means from surrounding corners				
7					Bearings Standing
8	Original				Bar post at corner Stone is the corner known from remains of bearing stump.
23	Burr Oak Burr Oak	5 5	S — W N — E	18 26	The angle to both trees is the same
24	Burr Oak	8	N 75 E	9½	No other tree near
					Surveyed for Marshall Hannum & James A. Jones Sept 28th 1880.

STATE OF WISCONSIN, Grant County, } ss.

CERTIFICATE OF SURVEY.

I, Joel Parker, County Surveyor in and for the County and State aforesaid, do hereby certify that I have executed the Survey represented by the foregoing Plat and annexed Field Notes of Survey, in accordance with the State Laws and Instructions of the Commissioner of the General Land Office. Scale, 80 chains to 4 inches. The figures in red ink are the lengths of the lines as stated in the Field Notes of the Government Survey.

Declination of the Magnetic Meridian from the True Meridian ..... East. The variation of needle adopted in establishing corners is 8° 30' East.

WITNESS my hand this Eighth day of November A. D. 1880

Samuel Wilkinson
A. Ennis Judd } Chainmen.

Joel Parker Surveyor.