Section 14 Township 6 North Range 4 West of 4th P. M.

102

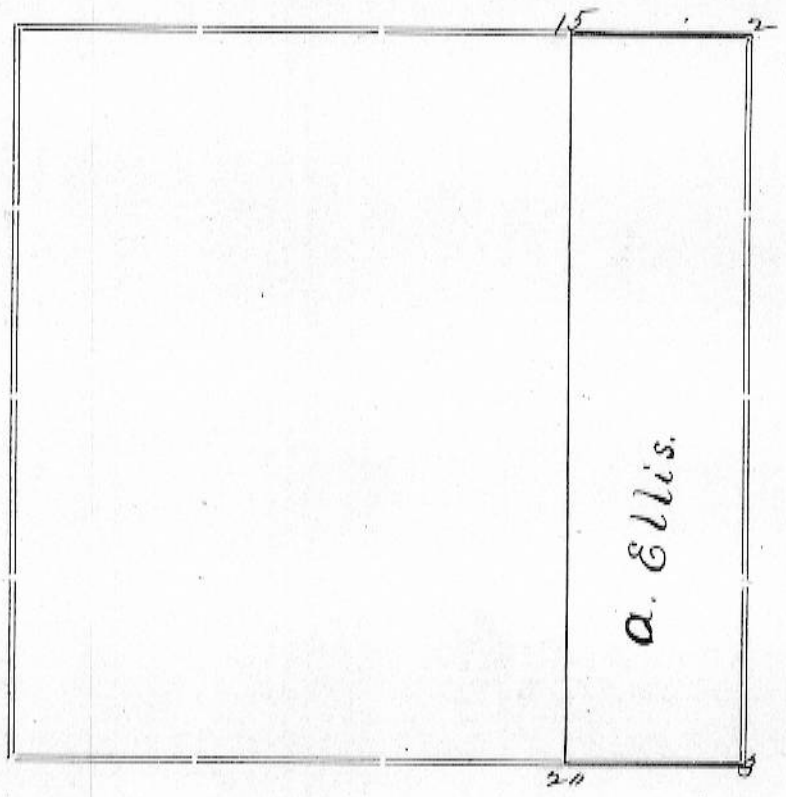

Dr. A. Ellis

Corners	Bearing Trees	In. Dia.	Courses they Bear	Links Distant	REMARKS
2	White Oak " "	9 12	N 78 W S 32 E	33½ 24	
3	White Oak Bur Oak	20 7	S 76 E S 69 W	380 154	
15	White Oak	5	S 48½ E	64½	
20	White Oak " "	7 8	N 76¼ E N 31 E	92½ 90	

CERTIFICATE OF SURVEY.

STATE OF WISCONSIN, } ss.
GRANT COUNTY, }

I, J. C. Scott, County Surveyor in and for the County and State aforesaid, do hereby certify that I have executed the Survey represented by the foregoing Plat and annexed Field Notes of Survey, in accordance with the State Laws and Instructions of the Commissioner of the General Land Office. Scale, 80 chains to 4 inches. The figures in red ink are the lengths of the lines as stated in the Field Notes of the Government Survey.

Declination of the Magnetic Meridian from the True Meridian ..... East. The variation of needle adopted in establishing corners is 7° 30' East.

WITNESS my hand this 1st day of Sept A. D. 1881

..... } Chainmen.

J. C. Scott. Surveyor.