ection 36 Township 3 North Range 3 West of 4th P. M.

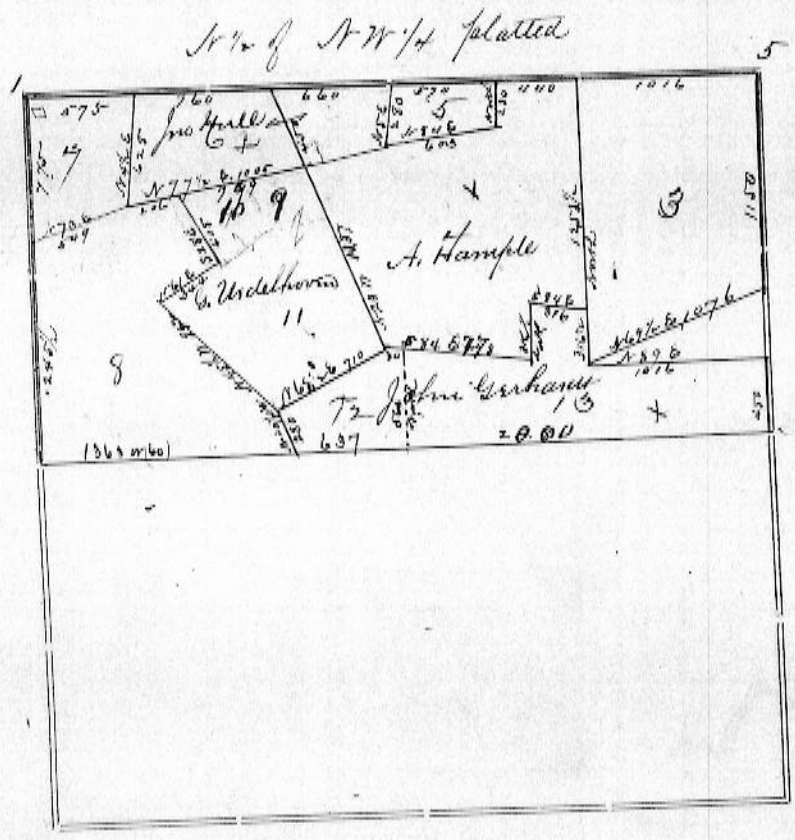

May 14th. 1881

Corners	Bearing Trees	In. Dia.	Courses they Bear	Links Distant	REMARKS
					No bearing trees were taken to any corner, only stakes
					put in. The courses and distances all as represented on
					plat above. The survey was made for Jno Gerhard
					Gerhard Underthorn, A. Hample and Joseph Hull, Comprising
					Lots Nos. 4. 6. 9. 10. 11. 12. & 13

CERTIFICATE OF SURVEY.

STATE OF WISCONSIN, } ss.
GRANT COUNTY, }

I, J. C. Scott, County Surveyor in and for the County and State aforesaid, do hereby certify that I have executed the Survey represented by the foregoing Plat and annexed Field Notes of Survey, in accordance with the State Laws and Instructions of the Commissioner of the General Land Office. Scale, ~~80~~ 40 chains to 4 inches. The figures in red ink are the lengths of the lines as stated in the Field Notes of the Government Survey.

Declination of the Magnetic Meridian from the True Meridian ..... East. The variation of needle adopted in establishing corners is 7° 10 East.

WITNESS my hand this 1st day of September A. D. 18 81

..... } CHAINMEN.
.....

J. C. Scott SURVEYOR.