Section 23 Township 7 North Range 4 West of 4th P. M.

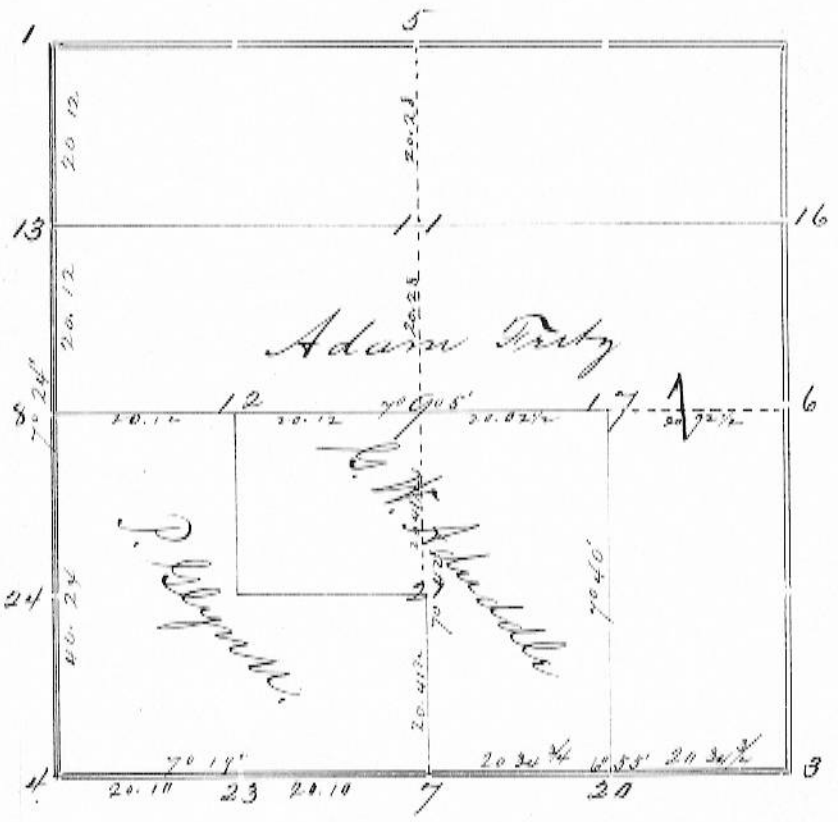

To Adam Doty, G. W. Ardell & P. Glyn, June 17th, 1882.

Corners	Bearing Trees	In. Dia.	Courses they Bear	Links Distant	REMARKS
1	Original in	Good	condition		
3	White Oak Original in White Oak	18 Fair 6	N 74½ E condition N 84 W	15½ one tree 45½	Standing but girdled & dead. Bearing and dome & lying in ground Made two bearings
4	Br. Oak Original	5	S 12 W	59	Made this tree bearing tree as one of the others is in poor condition
5	Stake and pile of Stone set by McClain.				
6	One original tree standing in Good Condition				
7	Burr Oak Set Stone	4	N. 61¾ E	37	Located this corner from stumps of an original bearing tree and found which the other stood by digging for
8	Burr Oak " "	5 9	N 66½ E N 8 W E	73½ 108½	All evidence of this corner was gone and I located it by running on the whole section line & placed it midway between #11
9	White Oak Black "	16 26	S 61° 20' W N 40 W	58 62½	Intersection of E & W & N & S ¼ lines
11	Br Oak	10	S 40 W	6½	Burr Oak & N 40 E 24½
12	Burr Oak Black Oak	6 11	S 74¾ E N 40 E	63 32	Stake & pile of Stone
13	Black Oak " "	11 5	S 43 E S 21 W	10½ 13	
17	White Oak " "	16 16	N 52 W N 10½ W	38 16	
20	Hackberry Yellow Oak	7 8	S 23½ E N 47½ W	13 61	
21	Red Oak Black " Stone "6"x16"x30"	18 10	N 5 1/4 E S 50¼ W	12 44	Set a good sized Stone with pile of stone around it
23	Box Elder Willow	6 6	N 39½ E N 20½ W	21½ 42	

CERTIFICATE OF SURVEY.

STATE OF WISCONSIN, GRANT COUNTY, } ss.

I, J. C. Scott, County Surveyor in and for the County and State aforesaid, do hereby certify that I have executed the Survey represented by the foregoing Plat and annexed Field Notes of Survey, in accordance with the State Laws and Instructions of the Commissioner of the General Land Office. Scale, 80 chains to 4 inches. The figures in red ink are the lengths of the lines as stated in the Field Notes of the Government Survey.

Declination of the Magnetic Meridian from the True Meridian ..... East. The variation of needle adopted in establishing corners is 7° 30' East.

WITNESS my hand this 17 day of June A. D. 18 82.

G. W. Ardell
Hiram Ardell } Chainmen. J. C. Scott Surveyor.