Section 2 Township 3 North Range 2 West of 4th P. M.

124

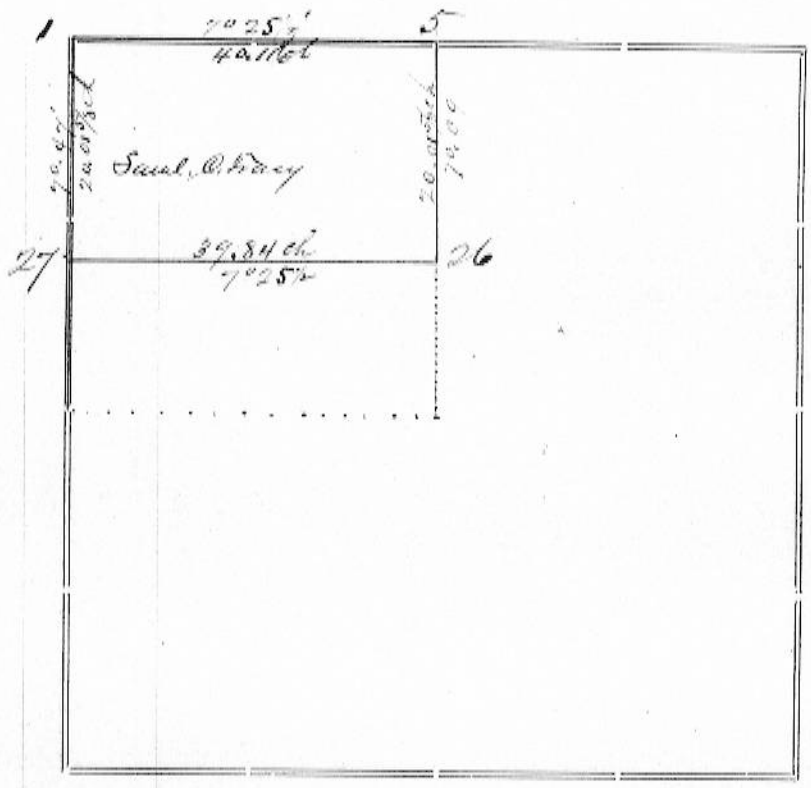

Surveyed for Saml. A. Tracy May 10th, 1882

Corners	Bearing Trees	In. Dia.	Courses they Bear	Links Distant	REMARKS
1	Stone				set when original trees were standing
5	Stone set by some previous surveyor				
26	Stone set on line		25 01/8 chains	North of 5	
27	White Oak Black Oak Stake	9 6	S 30½ W S 47 E	71½ 43 3/4	

STATE OF WISCONSIN, } ss.
GRANT COUNTY,

CERTIFICATE OF SURVEY.

I, J. C. Scott, County Surveyor in and for the County and State aforesaid, do hereby certify that I have executed the Survey represented by the foregoing Plat and annexed Field Notes of Survey, in accordance with the State Laws and Instructions of the Commissioner of the General Land Office. Scale, 80 chains to 4 inches. The figures in red ink are the lengths of the lines as stated in the Field Notes of the Government Survey.

Declination of the Magnetic Meridian from the True Meridian ..... East. The variation of needle adopted in establishing corners is 7° 30' East.

WITNESS my hand this 14 day of Oct A. D. 1882.

..... } CHAINMEN.

J. C. Scott SURVEYOR.