Section 33 Township 2 North Range 1 West of 4th P. M.

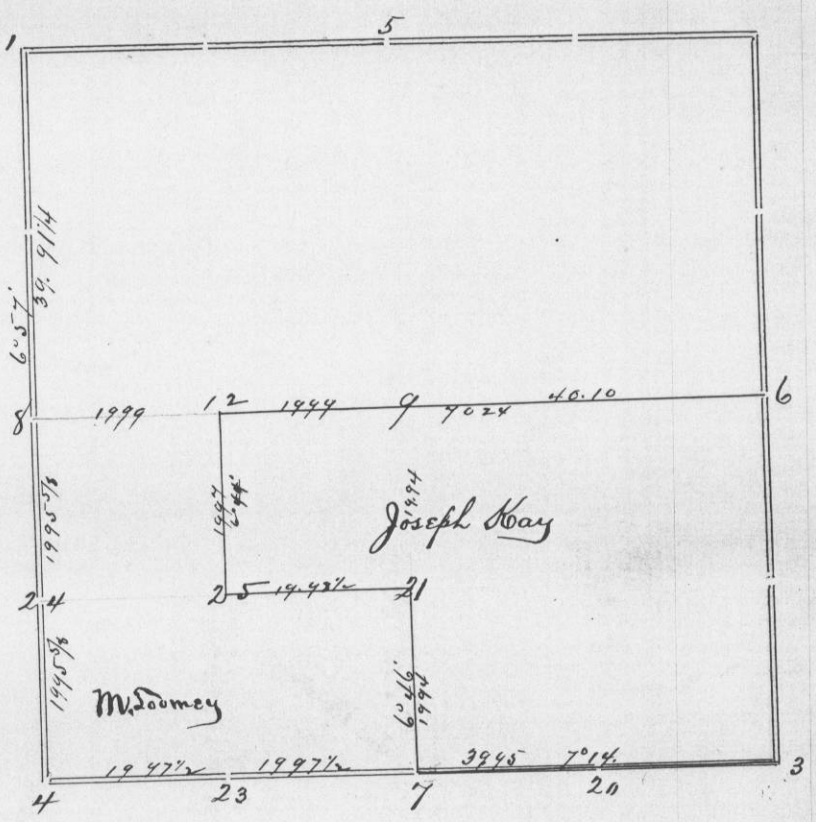

Surveyed for Joseph Kay

Corners	Bearing Trees	In. Dia.	Courses they Bear	Links Distant	REMARKS
1	Stone Corner				This Corner Stone is reputed to have been set by Overton when remains of original bearing trees were in existance
3	Stone Corner				This corner like preceding corner has been a long time located and undisputed
4	Stone Corner				Same as above
5	Stake				This Stake was an old one and is undoubtedly correct as Le Fevres and highway indicates its correctness
6	Stone Corner				Same remarks apply to this corner as to Nos 1-3 & 4
7	S E cor of Foundation of M. Toomeys House & Drove Stake		N 50¼ W	111	Run out the whole section line from 4 to 3 and find the corner as located by Barber in June 1879
8	Drove a Stake				Located this corner by survey of whole line from 1 to 4. at 24 chains was a Stone said to have been set when there was a stone for No 8. and taking that as a guide it would locate 8 midway between 1 & 4 and in a right line
9	Drove a Stake				Located this corner at intersection of straight & Section Lines
12	Set a Stone				Located midway between 9 & 8
20	Set a Stone				When I run the line from 4 to 3. I set a temporary stake at 20 ch. for 23 also at 40 ch for 7 and then run from Toomeys house to find cor located by Barber in 1879 the same as and for 20 I look for stone could not find any but found that the soil had been disturbed where the stone should have been, when I returned back to 23 I found my temp. stake missing
21	Cottonwood Drove Oak Stake	30	S 79¼ E	21¼	
23	Drove a Stake				Located midway between 9 & 7
24	Stone Corner				This corner is said to have been located many years. I find it to be ¼ of the distance from 4 to 1 laid in the same straight line.
25	Drove a Stake Box Elder	14	S 3½ E	94	Located at intersection of 1/8 & 1/16 line there has been a good deal of washed dirt settled here and in digging to set the stake I came upon a stone that had the appearance of having formerly set for a corner

CERTIFICATE OF SURVEY.

STATE OF WISCONSIN, GRANT COUNTY, } ss.

I, J. C. Scott, County Surveyor in and for the County and State aforesaid, do hereby certify that I have executed the Survey represented by the foregoing Plat and annexed Field Notes of Survey, in accordance with the State Laws and Instructions of the Commissioner of the General Land Office. Scale, 80 chains to 4 inches. The figures in red ink are the lengths of the lines as stated in the Field Notes of the Government Survey.

Declination of the Magnetic Meridian from the True Meridian ..... East. The variation of needle adopted in establishing corners is 7° East.

WITNESS my hand this 3 d day of September, A. D. 1883

P. B. Nicholas, B. F. Lucas } Chainmen.

J. C. Scott Surveyor.