Section 11 Township 7 North Range 3 West of 4th P. M.

146

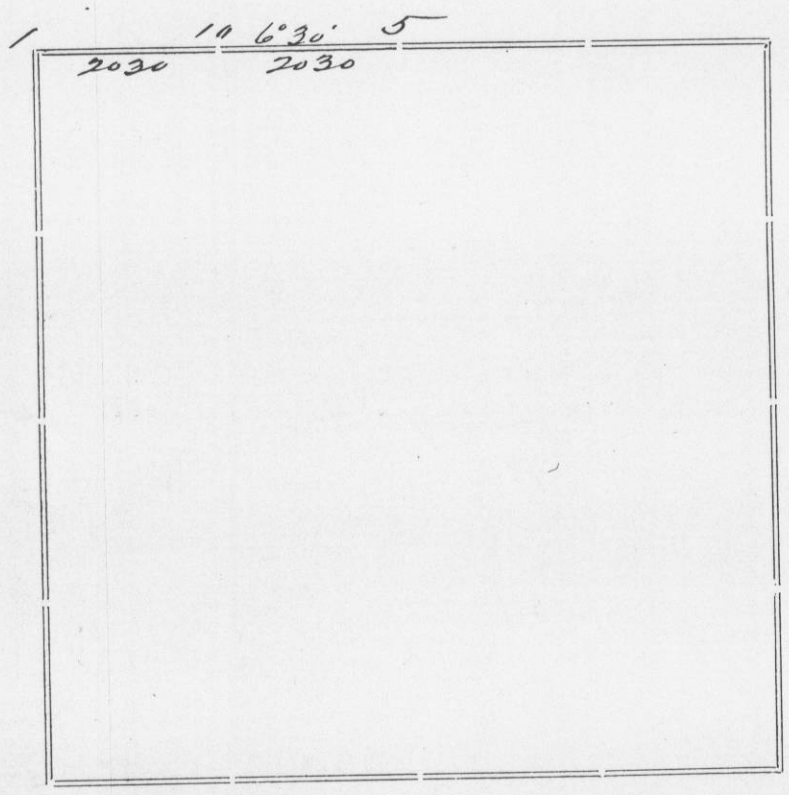

Corners	Bearing Trees	In. Dia.	Courses they Bear	Links Distant	REMARKS
1	Br Oak " "	11 4	S 76½ W. S 19¾ E	135 177½	New Bearings located by me Jany 5- 1883 from remains of Original bearing trees.
5	Hickory do	7 12	S 31 W. N 75 E	209 121½	Original in good condition New in place of Br Oak that is almost destroyed.
10	Black Oak do do	7 4½	N 76 E N 3¾ W	119½ 87	

CERTIFICATE OF SURVEY.

STATE OF WISCONSIN, GRANT COUNTY, } ss.

I, J. C. Scott, County Surveyor in and for the County and State aforesaid, do hereby certify that I have executed the Survey represented by the foregoing Plat and annexed Field Notes of Survey, in accordance with the State Laws and Instructions of the Commissioner of the General Land Office. Scale, 80 chains to 4 inches. The figures in red ink are the lengths of the lines as stated in the Field Notes of the Government Survey.

Declination of the Magnetic Meridian from the True Meridian ..... East. The variation of needle adopted in establishing corners is 7° East.

WITNESS my hand this 12th day of Nov A. D. 1883

Geo Campbell
Lincoln Tuttle
} Chainmen.

J. C. Scott Surveyor.