Section 16 Township 5 North Range 6 West of 4th P. M.

148

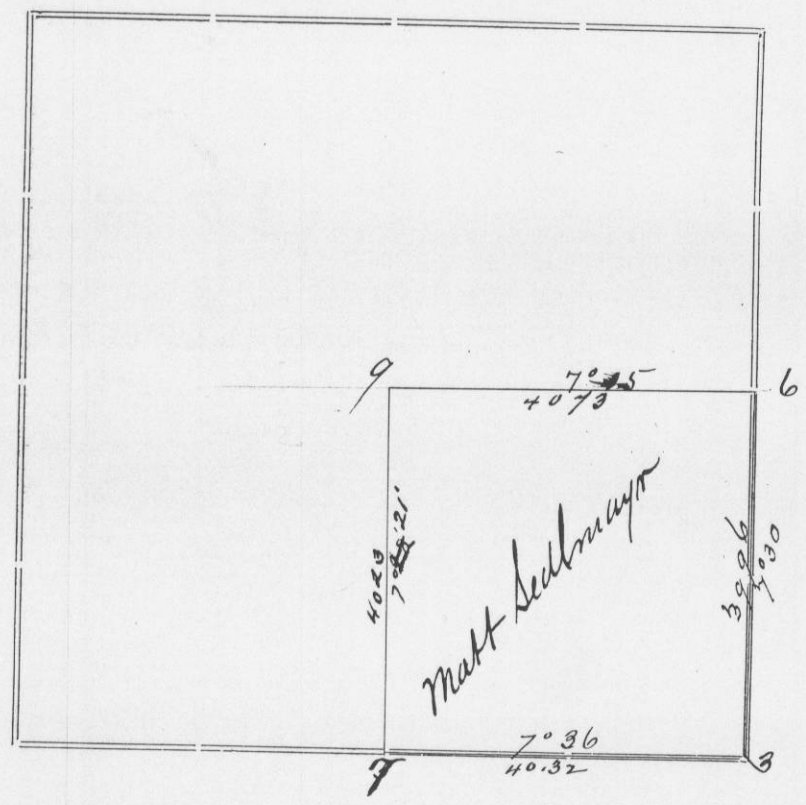

Dec 16th 1883

Corners	Bearing Trees	In. Dia.	Courses they Bear	Links Distant	REMARKS
3	Original				
6	Original				
7	Original				Stake at this corner that has long been recognized by all parties
9	White Oak	18	S 72 E	46.	Old Stake located by some former Survey

STATE OF WISCONSIN, } ss.
GRANT COUNTY,

CERTIFICATE OF SURVEY.

I, ..., County Surveyor in and for the County and State aforesaid, do hereby certify that I have executed the Survey represented by the foregoing Plat and annexed Field Notes of Survey, in accordance with the State Laws and Instructions of the Commissioner of the General Land Office. Scale, 80 chains to 4 inches. The figures in red ink are the lengths of the lines as stated in the Field Notes of the Government Survey.

Declination of the Magnetic Meridian from the True Meridian ..... East. The variation of needle adopted in establishing corners is 7° East.

WITNESS my hand this 20th day of December A. D. 1883

..... } CHAINMEN.

J. C. Scott ..... SURVEYOR.