Section 13 Township 5 North Range 2 West of 4th P.M.

156

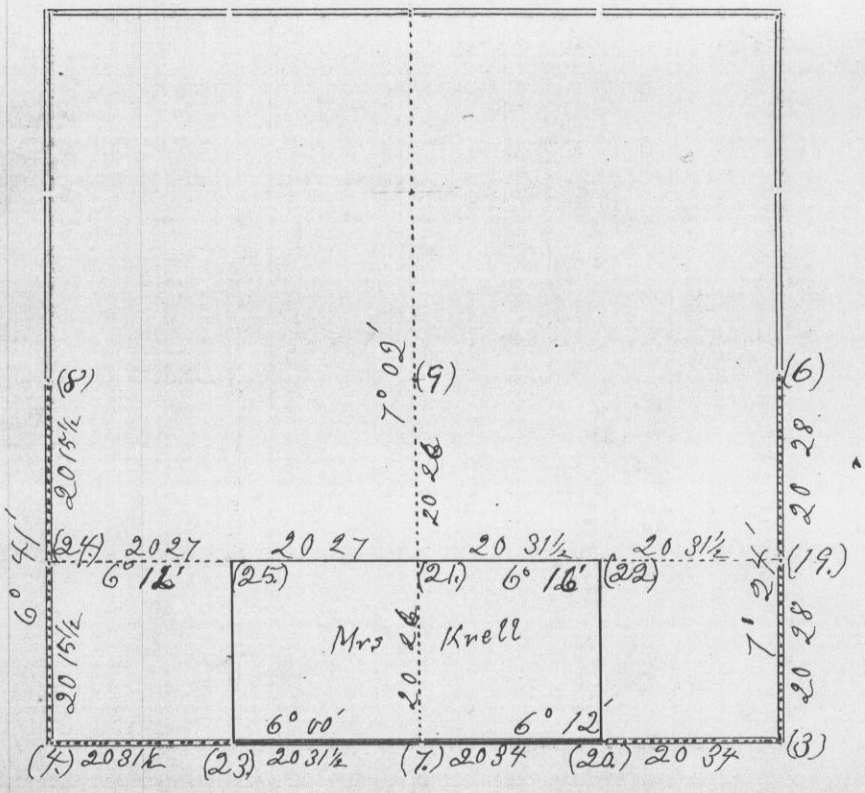

Corners	Bearing Trees	In. Dia.	Courses they Bear	Links Distant	REMARKS
8	Elm	4	S 36½ W	19	
4	Br. Oak	11	N 38 E	386	Other tree gone, found old stake under fence
6	Stone				Said to occupy position of old corner, Tree gone
8	Burr Oak	10	S 46 E	53	Found remains of old bearing trees
9	White Oak	Stump	excepted	by all parties as old corner tree	
7	White Oak original				Found remains of other tree
20	Burr Oak	10	N 44½ E	106	
	Burr Oak	10	N 14 W	159	
21	White Oak	22	S 7½ W	89	
	White Oak	14	N 26½ E	21	
22	N E corn Large rock with 4 inch grove around base		S 13 W	259	
23	Burr Oak	10	N 3 W	190	
24					
25	Stake				
19	Stake				

CERTIFICATE OF SURVEY.

STATE OF WISCONSIN, GRANT COUNTY, } ss.

I, T. C. Beardsley Deputy, County Surveyor in and for the County and State aforesaid, do hereby certify that I have executed the Survey represented by the foregoing Plat and annexed Field Notes of Survey, in accordance with the State Laws and Instructions of the Commissioner of the General Land Office. Scale, 80 chains to 4 inches. The figures in red ink are the lengths of the lines as stated in the Field Notes of the Government Survey.

Declination of the Magnetic Meridian from the True Meridian ..... East. The variation of needle adopted in establishing corners is 7° East.

WITNESS my hand this 10th day of April A. D. 1885

Henry Shuffener
Charles W. Mayes } Chainmen.

T. C. Beardsley Surveyor.