Section 1 Township 5 North Range 2 West of 4th P. M.

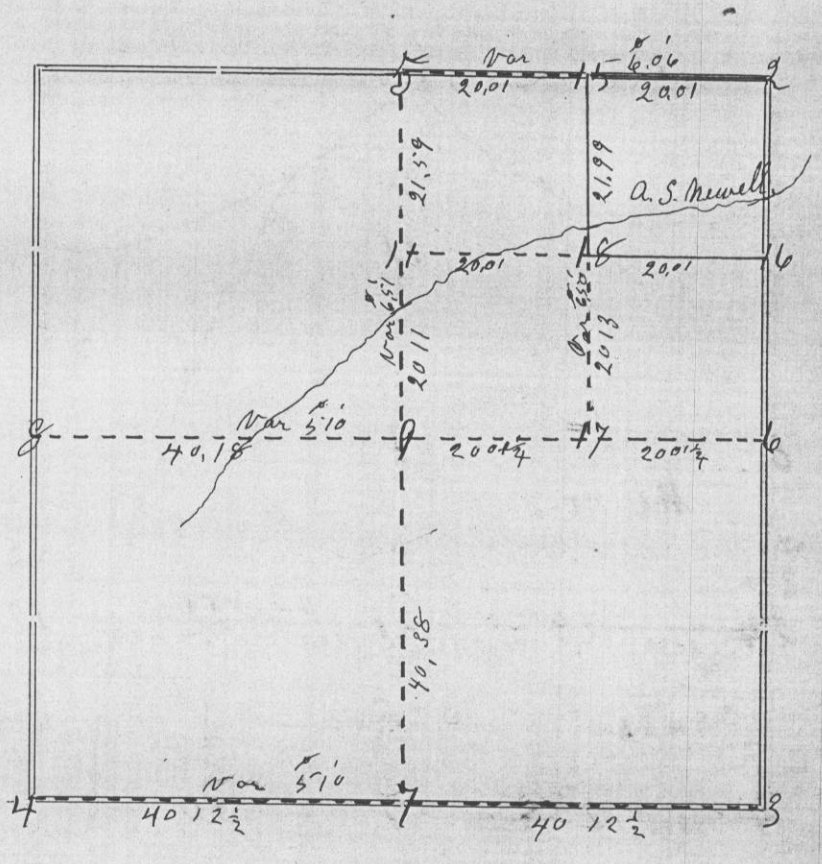

Corners	Bearing Trees	In. Dia.	Courses they Bear	Links Distant	REMARKS
2	W Oak	22	N 74½ W	120	Stone 9 X 13 X 3½ in
4					Original
5	W Oak	8	N 13½ W	184	Established from the roots of Original Bearings
7	W Oak " "	16 20	S 85¼ E N 13½ E	202 403½	Established Equidistant between 3 and 4
8					Stone set by some previous surveyor found to be correct.
9	Hickory W Oak	8 6	S 39¾ E S 84 W	22½ 54	
11	Set Stone		7 X 2 X 14 in		
15	B Oak " " W Oak	12 14	S 82½ E 3 X 9 X 24 in S ½ E	366½ 371	
16	Stone "		3 X 7 X 24 in		
18	B Oak " "	6	S 7 E N 43¾ E	25 17	Set Stone 3 X 8 X 21 in

CERTIFICATE OF SURVEY.

STATE OF WISCONSIN, } ss.
GRANT COUNTY,

I, ..., County Surveyor in and for the County and State aforesaid, do hereby certify that I have executed the Survey represented by the foregoing Plat and annexed Field Notes of Survey, in accordance with the State Laws and Instructions of the Commissioner of the General Land Office. Scale, 80 chains to 4 inches. The figures in red ink are the lengths of the lines as stated in the Field Notes of the Government Survey.

Declination of the Magnetic Meridian from the True Meridian ..... East. The variation of needle adopted in establishing corners is ..... East.

WITNESS my hand this 26 day of April A. D. 189 0

August Kreis
George Bowden } CHAINMEN.

Herbert J. Goold ..... SURVEYOR.