ection 16 Township 6 North Range 4 West of 4th P. M.

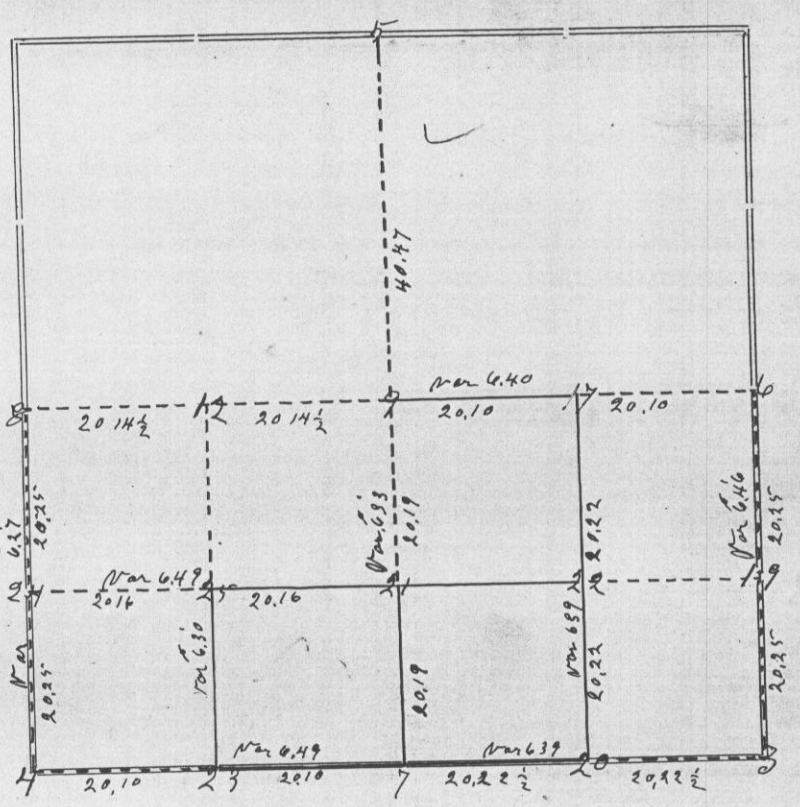

Corners	Bearing Trees	In. Dia.	Courses they Bear	Links Distant	REMARKS
3	Stake in pile of		Stone		Set from remains of Origenal bearings
4	B Oak	8	Corner		Set Stone 3 lks East
5	Br Oak B "	4 6	S 11¾ W N 16½ W	27 12	
6	B Oak " "	14 24	N 7½ E S 56 W	68 304	Established from remains of Origenal
7	Stake in pile of Stone				Set from remains of Origenal Bearings
8	Parties promised	To Set	Stone		
9	Br Oak " "	20 18	N 11½ W S 69 "	49 52	
12	Set Stake				
17	Stake in maund of Stone				
19	Elm Hickory	24 8	S 2¾ W S 39¼ E	36 23	
20	Stone	2 X 6 X 34 in			
21	Stone	5 X 6 X 16 "			
22	" "	6 X 10 X 20			
23	" "	3 X 7 X 20			
24	Set Stake				
25	Set Stone				

CERTIFICATE OF SURVEY.

STATE OF WISCONSIN, GRANT COUNTY, } ss.

I, Herbert J. Goold, County Surveyor in and for the County and State aforesaid, do hereby certify that I have executed the Survey represented by the foregoing Plat and annexed Field Notes of Survey, in accordance with the State Laws and Instructions of the Commissioner of the General Land Office. Scale, 80 chains to 4 inches. The figures in red ink are the lengths of the lines as stated in the Field Notes of the Government Survey.

Declination of the Magnetic Meridian from the True Meridian ..... East. The variation of needle adopted in establishing corners is ..... East.

WITNESS my hand this 30 day of May A. D. 1820

C Hainton
Will Brubaugh } CHAINMEN.

Herbert J. Goold SURVEYOR.