Section 5 Township 3 North Range 1 West of 4th P. M.

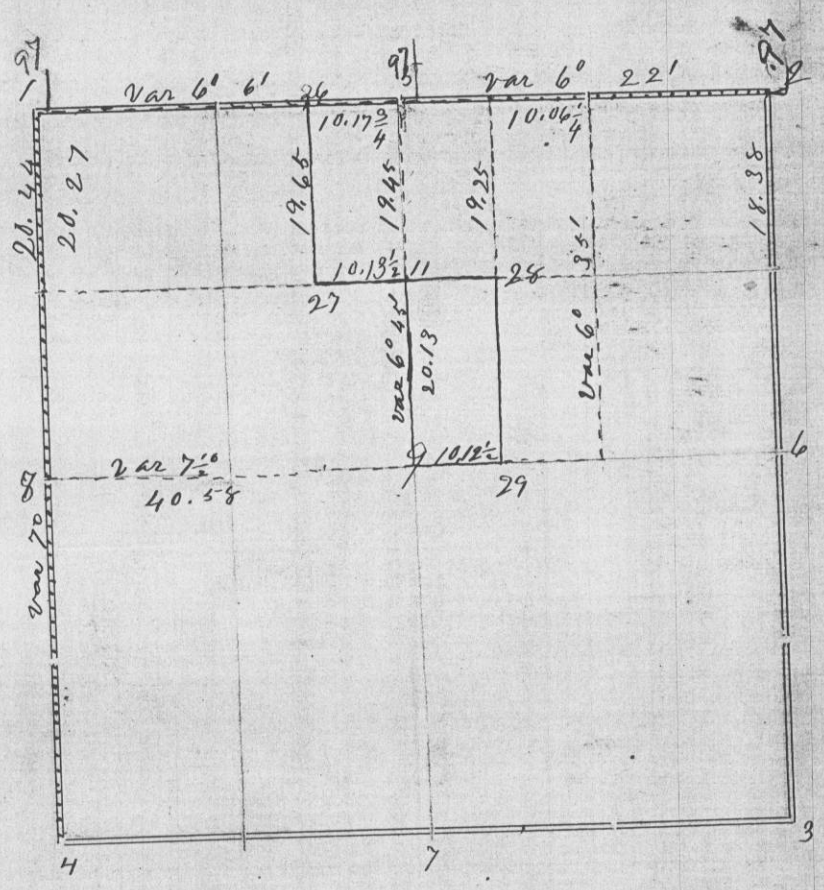

Corners	Bearing Trees	In. Dia.	Courses they Bear	Links Distant	REMARKS
1	Stone set by Joel Barber in 1876 No trees near				
2	Established from Lyma Corner. 97 east				
5	" " " " " " " " " "				
9	Ancient Stone Corner				
11	Equidistant between 9 & 5 set limestone rock with harrow tooth driven underneath on north side of road				
26	Equidistant between 5 and 10 marked same as 11				
27	Equidistant between 10 and 14 marked same as 11				
28	At intersection marked same as 11				
29	Equidistant between 9 and 17 stake				

CERTIFICATE OF SURVEY.

STATE OF WISCONSIN, } ss.
GRANT COUNTY,

I, Charles Sampson, County Surveyor in and for the County and State aforesaid, do hereby certify that I have executed the Survey represented by the foregoing Plat and annexed Field Notes of Survey, in accordance with the State Laws and Instructions of the Commissioner of the General Land Office. Scale, 80 chains to 4 inches. The figures in red ink are the lengths of the lines as stated in the Field Notes of the Government Survey.

Declination of the Magnetic Meridian from the True Meridian 6° 30' East. The variation of needle adopted in establishing corners is ..... East.

WITNESS my hand this 27th day of April A. D. 1891

Thomas Batson
Fred Beyer } CHAINMEN.

Charles Sampson SURVEYOR.