Section 18 Township 3 North Range 4 West of 4th P. M.

198

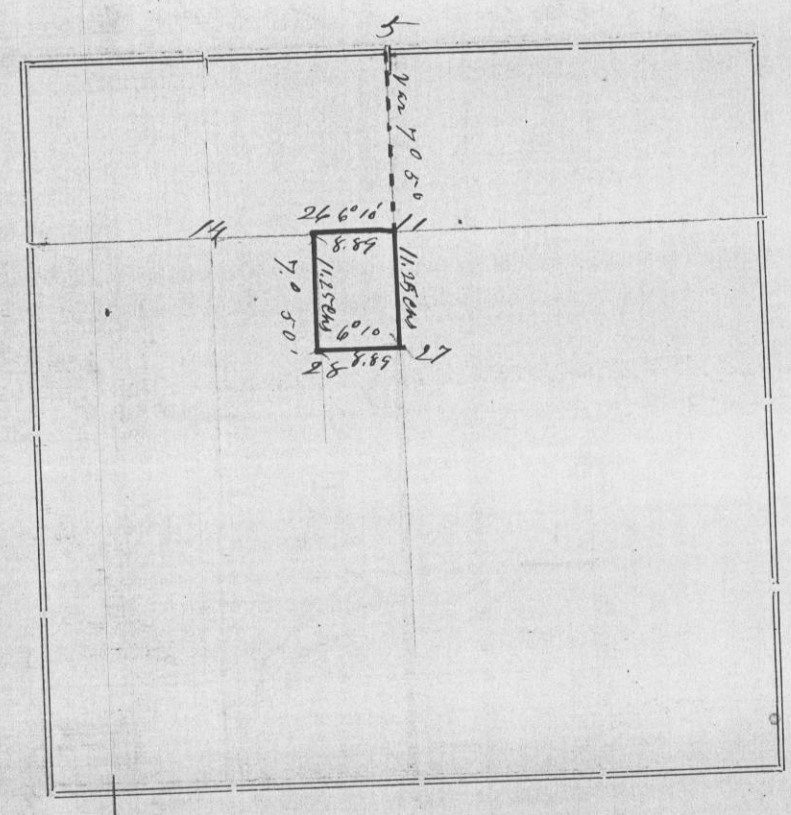

Corners	Bearing Trees	In. Dia.	Courses they Bear	Links Distant	REMARKS
5	Ancient corner				
14	ancient corner				
11	post				
26	post				
27	Shellbark Hickory	12	N 57¼ W	145	
28	stone mound				

CERTIFICATE OF SURVEY.

STATE OF WISCONSIN, } ss.
GRANT COUNTY,

I, Charles Sampson, County Surveyor in and for the County and State aforesaid, do hereby certify that I have executed the Survey represented by the foregoing Plat and annexed Field Notes of Survey, in accordance with the State Laws and Instructions of the Commissioner of the General Land Office. Scale, 80 chains to 4 inches. The figures in red ink are the lengths of the lines as stated in the Field Notes of the Government Survey.

Declination of the Magnetic Meridian from the True Meridian 6½ East. The variation of needle adopted in establishing corners is East.

WITNESS my hand this 22nd day of Jan A. D. 18 71

} CHAINMEN.

Charles Sampson SURVEYOR.