Section 11 Township 4 North Range 1 West of 4th P. M.

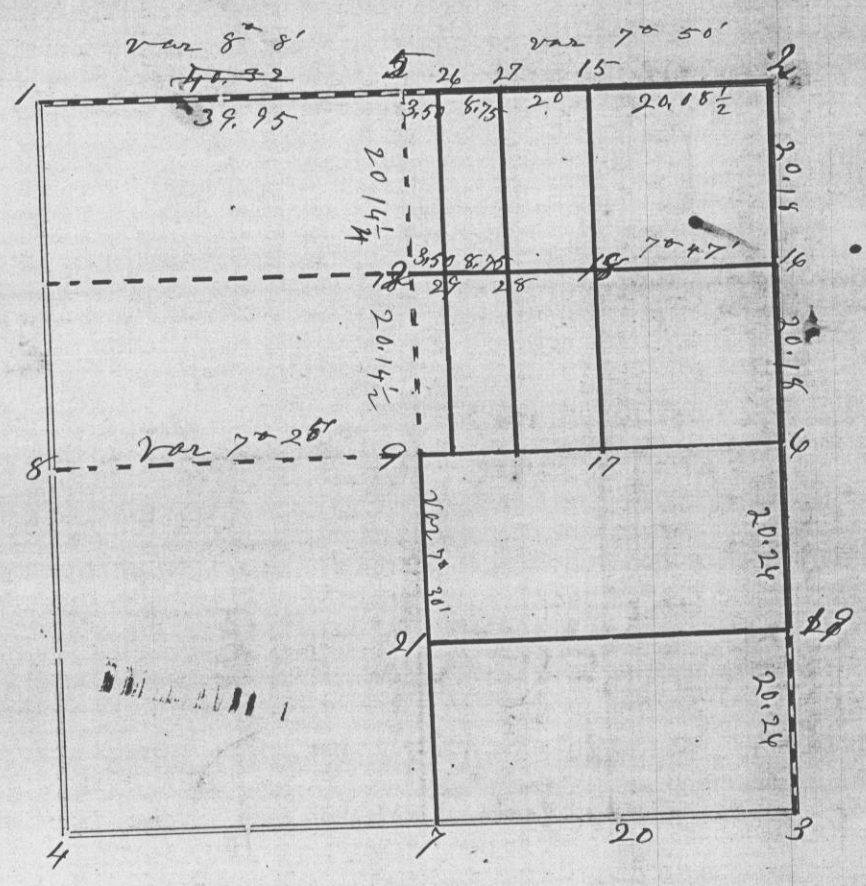

Corners	Bearing Trees	In. Dia.	Courses they Bear	Links Distant	REMARKS
1	Orig Rd Oak in good condition				
2	Established from nearest adjacent corners				
3	found remains of the roots of both original trees				
5	Burr Oak original still standing				
	Blk Walnut	12	S 9½ E	263	sun
		3	N 35 W one	86½	" "
6	"found" remains of both original tree				by Overton
7	Both original trees still standing. Rock with glass bottles around it established				
8	Found one original tree B. T. and stump of other				
	White Oak	80	N 77½° W	217½	
9	" " " "	10	" 5½° "	86½	
	White Oak	24	S 76 W	47	
19	" " " "	12	N 23 W	80	
21	Black Ash	14	S 72½ W	68½	
	White Oak	6	S 73½ E	35	
16	White Oak	16	N 3° E	48	
	" " " "	6	S 88¼ W	37	
18	Black Oak	24	S 10° E	3	

CERTIFICATE OF SURVEY.

STATE OF WISCONSIN, } ss.
GRANT COUNTY,

I, Charles Sampson, County Surveyor in and for the County and State aforesaid, do hereby certify that I have executed the Survey represented by the foregoing Plat and annexed Field Notes of Survey, in accordance with the State Laws and Instructions of the Commissioner of the General Land Office. Scale, 80 chains to 4 inches. The figures in red ink are the lengths of the lines as stated in the Field Notes of the Government Survey.

Declination of the Magnetic Meridian from the True Meridian 6½ East. The variation of needle adopted in establishing corners is 7½ East.

WITNESS my hand this 7th day of March A. D. 1892

James Kirkpatrick } CHAINMEN.
Jas. Dobson

Charles Sampson SURVEYOR.