Section 20 Township 8 North Range 1 West of 4th P. M.

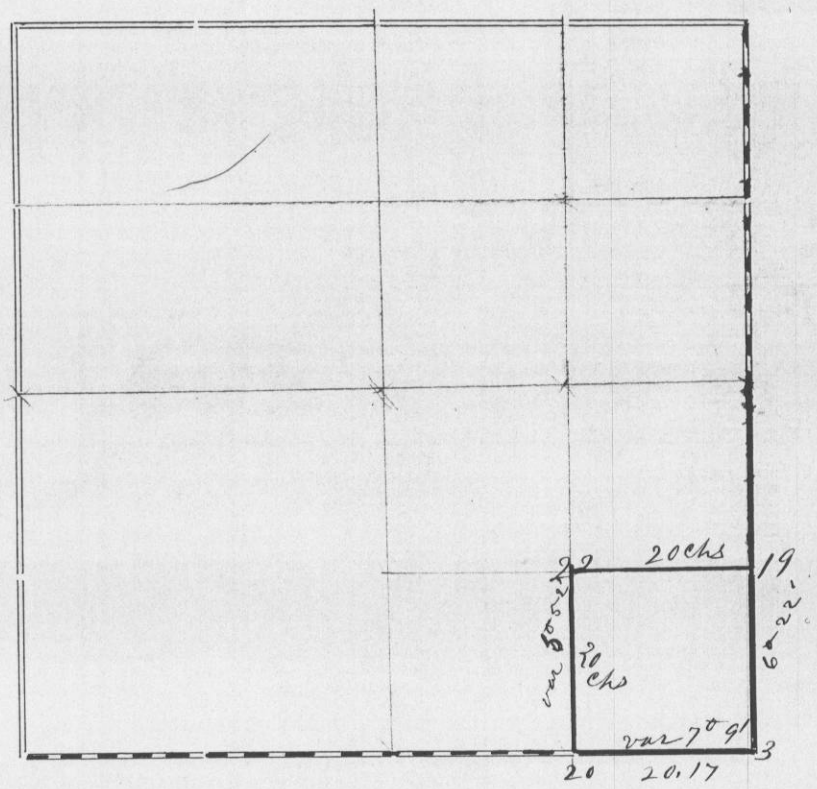

Corners	Bearing Trees	In. Dia.	Courses they Bear	Links Distant	REMARKS
20	White Ash	8	S 22½ W	91	
	Black " "	12	N 8° W	134	

CERTIFICATE OF SURVEY.

STATE OF WISCONSIN, } ss.
GRANT COUNTY,

I, Charles Sampson Deputy, County Surveyor in and for the County and State aforesaid, do hereby certify that I have executed the Survey represented by the foregoing Plat and annexed Field Notes of Survey, in accordance with the State Laws and Instructions of the Commissioner of the General Land Office. Scale, 80 chains to 4 inches. The figures in red ink are the lengths of the lines as stated in the Field Notes of the Government Survey.

Declination of the Magnetic Meridian from the True Meridian 6° 3' East. The variation of needle adopted in establishing corners is East.

WITNESS my hand this 20th day of April A. D. 18 92

John Kolar
Joseph Brannen } CHAINMEN.

Charles Sampson SURVEYOR.