Section 5 Township 1 North Range 2 West of 4th P. M.

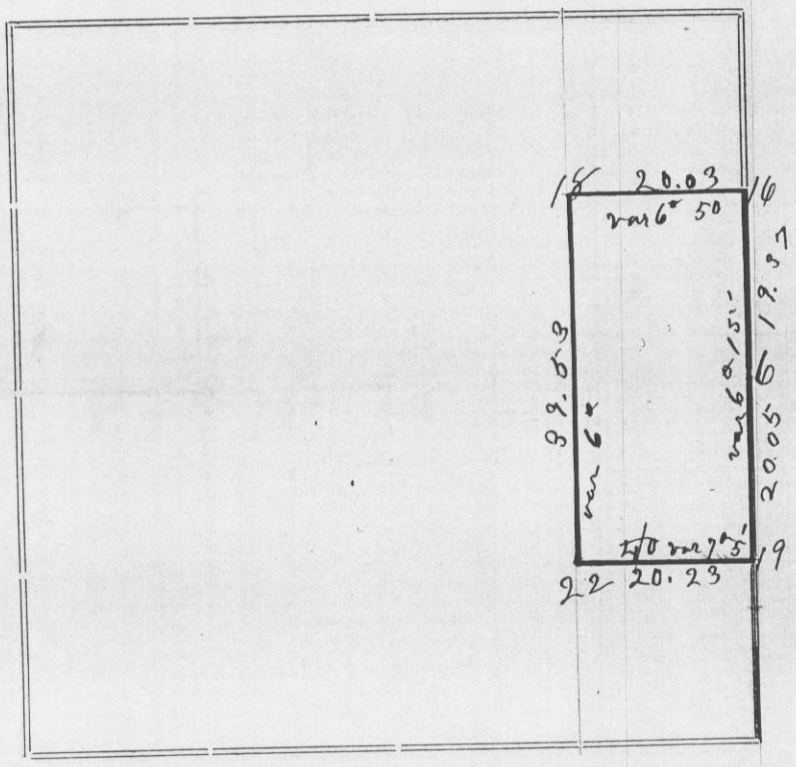

Corners	Bearing Trees	In. Dia.	Courses they Bear	Links Distant	REMARKS
6	Original Corner Stamp of U. S.			B.T.s	standing found roots of the other
16	Established by C. J. Overton.				Found remains of both of his Bearing Trees
18	" "	"	" "	"	" " " " " his Bearing Tree
19	Burr Oak "	7"	N 15° W	10 32	" " " " " " " "
	" " "	6	N 29½ W	96 5	taken by me
22	Hickory "	2½	N 43¾ E	21 2	" " " " both of his Bearing Trees
	Black Oak	5	N 6¼ E	71 5	taken by me

CERTIFICATE OF SURVEY.

STATE OF WISCONSIN, } ss.
GRANT COUNTY, }

I, Charles Sampson, County Surveyor in and for the County and State aforesaid, do hereby certify that I have executed the Survey represented by the foregoing Plat and annexed Field Notes of Survey, in accordance with the State Laws and Instructions of the Commissioner of the General Land Office. Scale, 80 chains to 4 inches. The figures in red ink are the lengths of the lines as stated in the Field Notes of the Government Survey.

Declination of the Magnetic Meridian from the True Meridian 0° 30' East. The variation of needle adopted in establishing corners is 7° East.

WITNESS my hand this 12th day of July A. D. 18 92

_____ } Chainmen.
_____ }

Charles Sampson Surveyor.