Section 7 Township 7 North Range 3 West of 4th P. M.

220

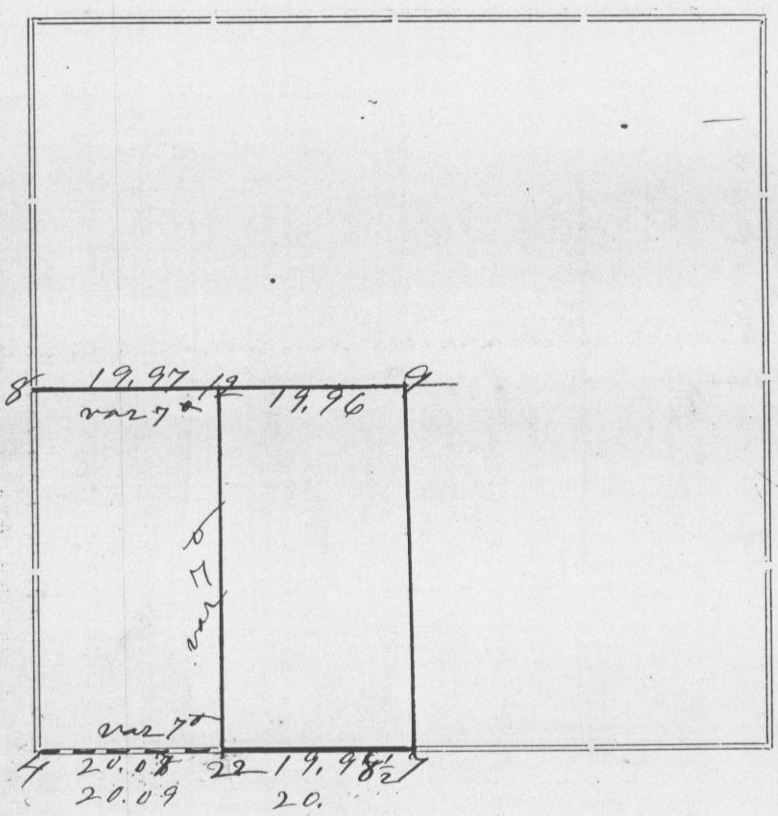

Corners	Bearing Trees	In. Dia.	Courses they Bear	Links Distant	REMARKS
8					Established by Applebee 1889
9					" " " " " " " "
7	Original				S. E. tree intact
4	Stake				Found decayed remains of both orig trees. Also of both original trees for town of Woodman

CERTIFICATE OF SURVEY.

STATE OF WISCONSIN,
GRANT COUNTY, } ss.

I, Charles Sampson, County Surveyor in and for the County and State aforesaid, do hereby certify that I have executed the Survey represented by the foregoing Plat and annexed Field Notes of Survey, in accordance with the State Laws and Instructions of the Commissioner of the General Land Office. Scale, 80 chains to 4 inches. The figures in red ink are the lengths of the lines as stated in the Field Notes of the Government Survey.

Declination of the Magnetic Meridian from the True Meridian 6° 30' East. The variation of needle adopted in establishing corners is 7° East.

WITNESS my hand this 17th day of October A. D. 1892

Fred Walts
Elijah Moon } CHAINMEN.

C. Sampson SURVEYOR.