Section 29 Township 2 North Range 2 West of 4th P. M.

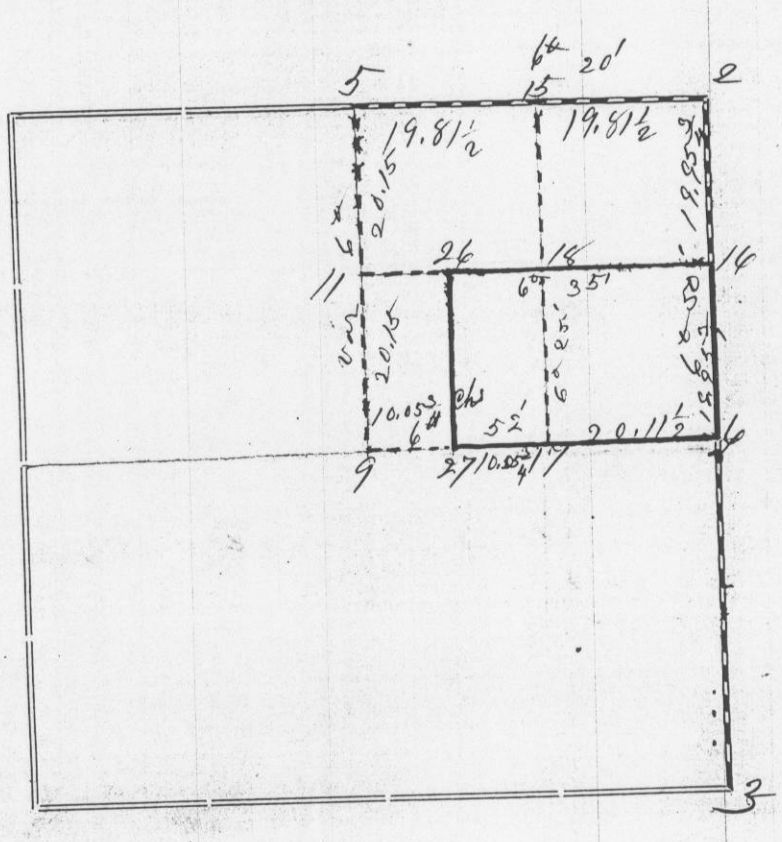

Corners	Bearing Trees	In. Dia.	Courses they Bear	Links Distant	REMARKS
5	Rock Placed by George McFall Found decayed remains of roots of both original bearing trees				
2 &	" "	"	" " "	"	" " " " " " " "
6	Established from survey of whole line				
	Black Oak	6	N 1° W	47½	new placed rock
	White Oak	6	N 52° W	58½	
14	Burr Oak	10	S 62° W	51	
	" " "	3½	S 8° E	52	
	Placed rock				
18	Bur Oak	16	S 29° W	188	
	Burr Oak	10	N 46° E	21	
26	Burr Oak	5	S 33° E	48½	
	" " " "	3	S 32° W.	30	
27	Double White Oak	5 and 6	N 14½° E	22½	
	White Oak	6	N 14½° W	36	
32	Found decayed remains of both original B. T.s				
9	Established by Henry A. Foulke in 1842. Found remains of both B.T.				

CERTIFICATE OF SURVEY.

STATE OF WISCONSIN, } ss.
GRANT COUNTY,

I, ..., County Surveyor in and for the County and State aforesaid, do hereby certify that I have executed the Survey represented by the foregoing Plat and annexed Field Notes of Survey, in accordance with the State Laws and Instructions of the Commissioner of the General Land Office. Scale, 80 chains to 4 inches. The figures in red ink are the lengths of the lines as stated in the Field Notes of the Government Survey.

Declination of the Magnetic Meridian from the True Meridian ..... East. The variation of needle adopted in establishing corners is ..... East.

WITNESS my hand this ..... day of ..... A. D. 18.....

..... } CHAINMEN. ..... SURVEYOR.