Section 10 Township 3 North Range 6 West of 4th P. M.

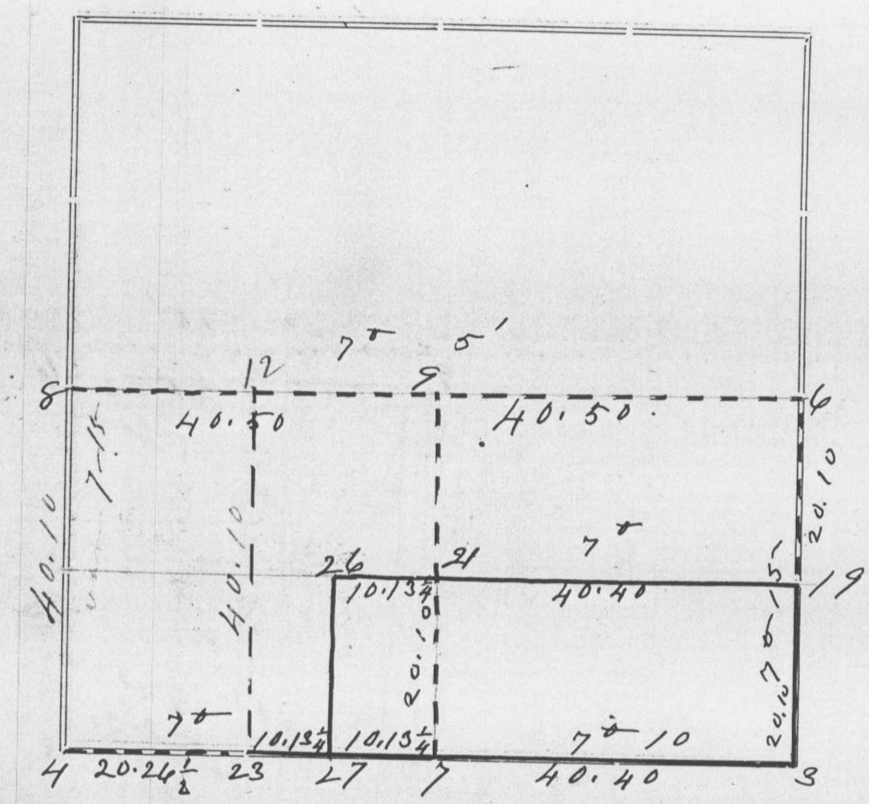

Corners	Bearing Trees	In. Dia.	Courses they Bear	Links Distant	REMARKS
3					Found Stumps of Both originals and also of both B.T.s for corresponding Cor of T & R 5
4					One tree down with blaze on it. Found stump of other
6					Found Stone and Stump of one B.T.
7					One B.T. still standing
8.					Found remains of both B.T.s
19	White Oak	8	N 70° W	2	
	" "	12	N 30° W	4	
	Aspen	6	N 45 E	2½	
23	Elm	20	S 25½° W	60	
	Ash	8	N 56½ E	11½	
26	Burr Oak	16	N 44° E	19	
	Black " "	16	N 21° W	16½	
21	Butternut	20	S 70½° E	39	
	Double Red Elm	30	N 40 E	72	
12	White Oak	24	S 62° W	59	
	" " "	20	N 38 W	60	

CERTIFICATE OF SURVEY.

STATE OF WISCONSIN, } ss.
GRANT COUNTY,

I, ..., County Surveyor in and for the County and State aforesaid, do hereby certify that I have executed the Survey represented by the foregoing Plat and annexed Field Notes of Survey, in accordance with the State Laws and Instructions of the Commissioner of the General Land Office. Scale, 80 chains to 4 inches. The figures in red ink are the lengths of the lines as stated in the Field Notes of the Government Survey.

Declination of the Magnetic Meridian from the True Meridian .... East. The variation of needle adopted in establishing corners is .... East.

WITNESS my hand this .... day of .... A. D. 18......

John Heiby John Steffin
Pohnes Glap m Fepton Wm H. Harrison } CHAINMEN.

.... SURVEYOR.