Section 33 Township 4 North Range 2 West of 4th P. M.

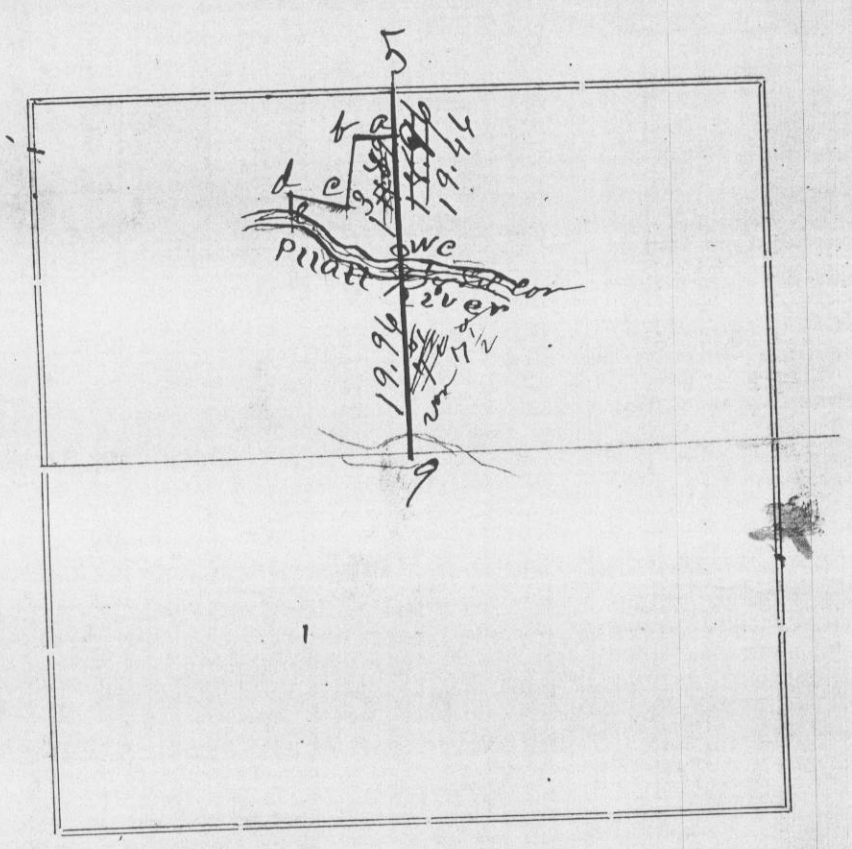

Corners	Bearing Trees	In. Dia.	Courses they Bear	Links Distant	REMARKS
5	Located in 1870 by Joseph Allen				
9	Established by Joseph Allen 1870				
	Sug ar	10	N 50° E	57	} mon.
	Bin oak	3	S 64° E	11	}
WC	50 lks North of 1/4 Cor				
	Boy Alder	28	N 27° W	110	
	Burr Oak	24	N 22½° W	216	
a	Stake				
b	iron Stake				
c	Stone				
	Willow	7	S 36½° E	46½	
	N. Bar of Mill		S 69 W	73½	
d	Stone	4 north		75	

5 to a	South	var 7½	5.07 chs
a " b	west	" 6° 45'	4.00
a " c	S 11° W	" 10°	7.50
c " d	N 75 W	" 10°	6.00
d " e	South	" 10	1.33

CERTIFICATE OF SURVEY.

STATE OF WISCONSIN, } ss.
GRANT COUNTY, }

I, Charles Sampson, County Surveyor in and for the County and State aforesaid, do hereby certify that I have executed the Survey represented by the foregoing Plat and annexed Field Notes of Survey, in accordance with the State Laws and Instructions of the Commissioner of the General Land Office. Scale, 80 chains to 4 inches. The figures in red ink are the lengths of the lines as stated in the Field Notes of the Government Survey.

Declination of the Magnetic Meridian from the True Meridian 6° 30' East. The variation of needle adopted in establishing corners is 7° East.

WITNESS my hand this 27th day of November A. D. 18 94.

Edward Clark
J. A. McPherson } CHAINMEN.

Charles Sampson SURVEYOR.