Section 11 Township 2 North Range 2 West of 4th P. M.

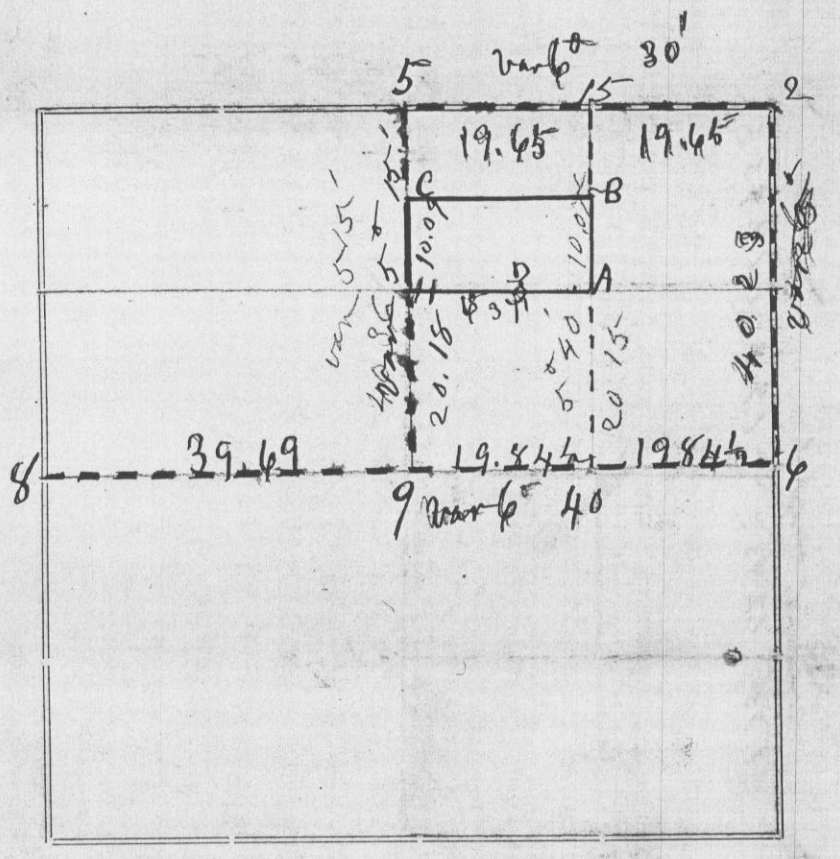

Corners	Bearing Trees	In. Dia.	Courses they Bear	Links Distant	REMARKS
2	Found remains of Orig B.T.'s				
6	Elm orig Standing Found Stump Bg Bo 6				
8	Stump of S.E. orig Standing both blaze upon it Found remains of the other				
5	Found Stumps of both original				
15	Old Stone Monument				
11	Limestone Water Elm	18 x 10 x 2 36	N 25° E	27½	
A	Blk Walnut " " "	5 4	N 30½° W N 11° W	15 62½	
B	Stone				
C	White Elm Triangular	24 Limestone	S 44 E 16 x 14	21½ x 3	
D	Stony White Elm	Lin line 40	East of ½ way N 37½	point 77	between A and 11

CERTIFICATE OF SURVEY.

STATE OF WISCONSIN, } ss.
GRANT COUNTY,

I, ..., County Surveyor in and for the County and State aforesaid, do hereby certify that I have executed the Survey represented by the foregoing Plat and annexed Field Notes of Survey, in accordance with the State Laws and Instructions of the Commissioner of the General Land Office. Scale, 80 chains to 4 inches. The figures in red ink are the lengths of the lines as stated in the Field Notes of the Government Survey.

Declination of the Magnetic Meridian from the True Meridian ..... East. The variation of needle adopted in establishing corners is ..... East.

WITNESS my hand this ..... day of ..... A. D. 18 .....

..... } CHAINMEN.

..... SURVEYOR.