Section 1 Township 1 North Range 2 West of 4th P. M.

254

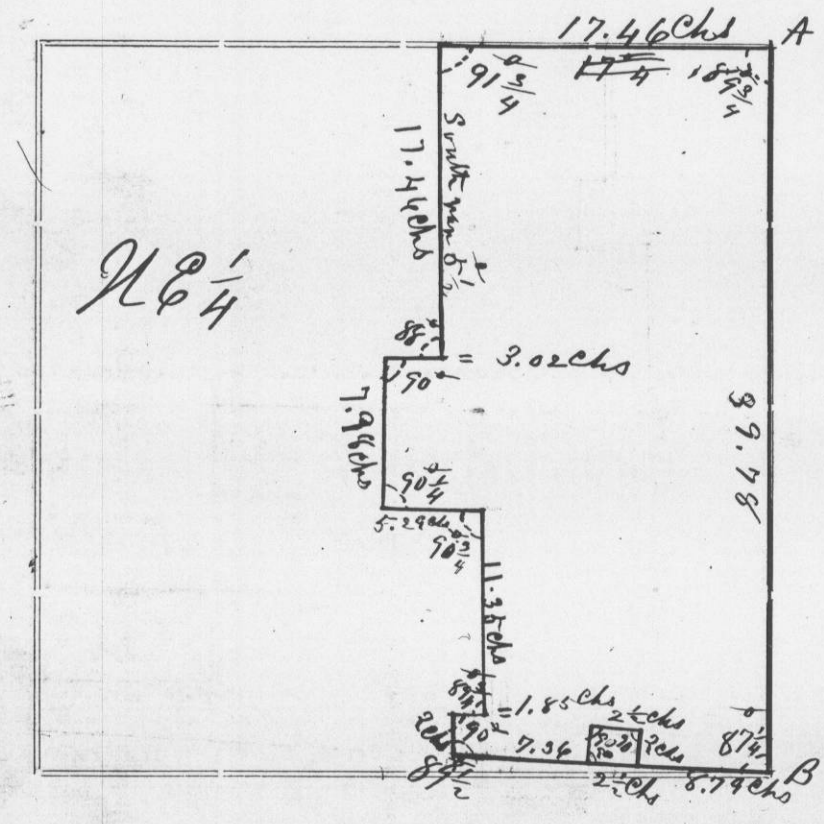

Corners	Bearing Trees	In. Dia.	Courses they Bear	Links Distant	REMARKS
A					Old Stone Corner
B	Black Walnut	16	South	30.34	
					At the other corners I only agreed to set stone

CERTIFICATE OF SURVEY.

STATE OF WISCONSIN, GRANT COUNTY, } ss.

I, Charles Simpson, County Surveyor in and for the County and State aforesaid, do hereby certify that I have executed the Survey represented by the foregoing Plat and annexed Field Notes of Survey, in accordance with the State Laws and Instructions of the Commissioner of the General Land Office. Scale, 80 chains to 4 inches. The figures in red ink are the lengths of the lines as stated in the Field Notes of the Government Survey.

Declination of ~~the~~ Magnetic Meridian from the True Meridian 6 1/2 East. The variation of needle adopted in establishing ~~corners is~~ lines 5 1/2 East.

WITNESS my hand this 9th day of April A. D. 18 85

E. D. Peak
Henry Hunsley } CHAINMEN.

C. Simpson SURVEYOR.