Section 15 Township 5 North Range 1 West of 4th P. M.

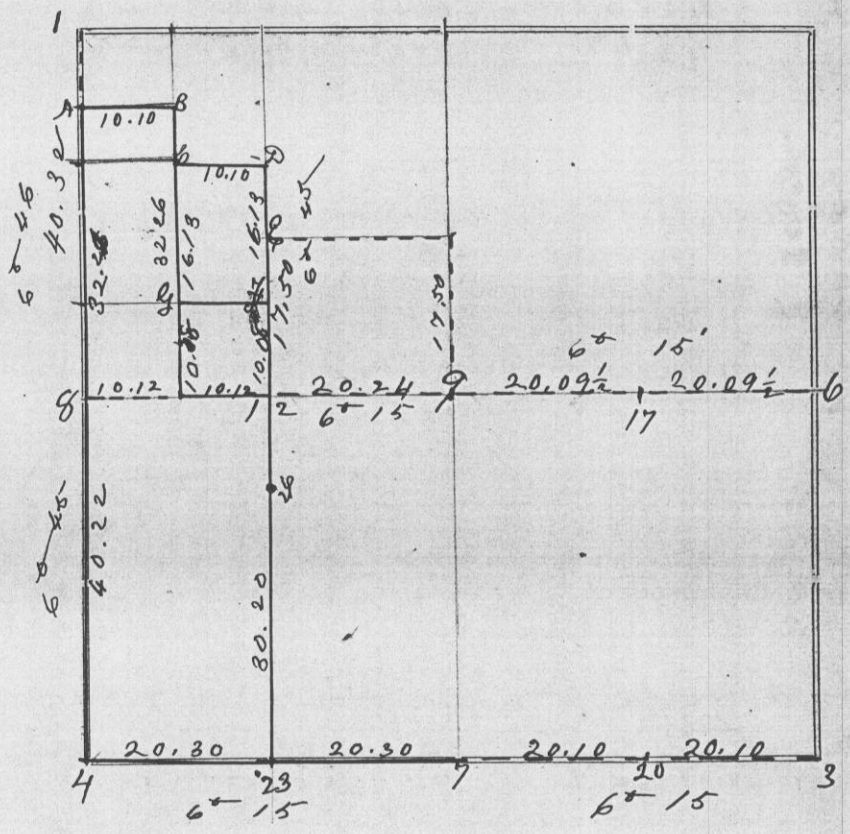

Corners	Bearing Trees	In. Dia.	Courses they Bear	Links Distant	REMARKS
1	Post in Stone with Smaller Stone underneath				Found stumps of both original B.T.'s
3	Stone just in by Barber				
4	Set stone with a smaller one underneath Found remains of both orig B.T.S				
6	Stone Found Stumps of both orig B.T.S				
7 &	Set Stone 6×6×8 with gas pipe 1 inch gas pipe 2½ feet long driven a foot below the surface				
8	Found Stumps of both original B.T.S Set Stone with a Smaller one underneath				
9	Corner by Geo R. Stuntz Found remains of both his bearing trees Set Blue Lime Stone 4×4×12 with Smaller rock underneath				
12	Set stone with Smaller one underneath				
17	Set by Stuntz in 1846				
20	" " " " " "				
26	Set stone				
A	Set Stone with small one underneath				
B	Stake ~~set~~ Set Pile at the S.E. corner of				Large Stone imbedded in the ground
6	Set stone with Smaller one underneath				
D	" " " " " " " " "				
E	" " " " " " " " "				
F	" " " " " " " " "				
G	" " " " " " " " "				
23	" " " " " " " " "				

CERTIFICATE OF SURVEY.

STATE OF WISCONSIN, } ss.
GRANT COUNTY,

I, Charles Sampson, County Surveyor in and for the County and State aforesaid, do hereby certify that I have executed the Survey represented by the foregoing Plat and annexed Field Notes of Survey, in accordance with the State Laws and Instructions of the Commissioner of the General Land Office. Scale; 80 chains to 4 inches. The figures in red ink are the lengths of the lines as stated in the Field Notes of the Government Survey.

Declination of the Magnetic Meridian from the True Meridian 6° East. The variation of needle adopted in establishing corners is East.

WITNESS my hand this 18th day of June A. D. 1899

Wm. Dranksater
Herbert Livingston } CHAINMEN.

C. C. Sampson SURVEYOR.