204

Section 31 Township 4 North Range 3 West of 4th P. M.

284

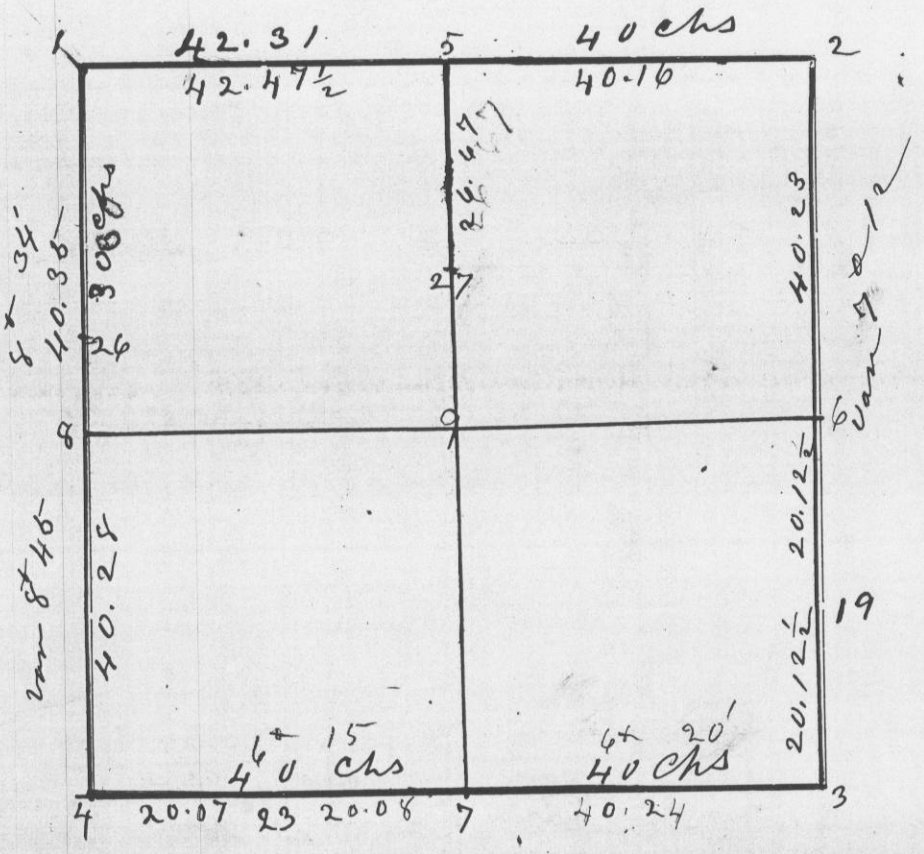

Corners	Bearing Trees	In. Dia.	Courses they Bear	Links Distant	REMARKS
1	Placed a triangular Rock 20 inches long over a hole drilled with a crow bar filled with lime Found old Stone and remains of Bearings				
2	Found old Stone. Bearings obliterated Placed Stone 8+ x 4½ x 25 over drilled hole filled with lime				
3	Found by measurement from 7 to S ¼ of 32-4-3 Bearings obliterated Placed Stone 4 x 11 x 22 over drilled hole filled with lime				
4	Found remains of Original Elm also Sugartree taken by Barber Red Oak	24	N 19° E	93	Set Stone 4 x 7 x 22 over hole drilled filled with lime
	Sugar	12	N 55½° E	137+	
5	Set Stone 5 x 7 x 24 over over drilled hole filled with lime Established by measurement of whole line				
6	Found remains of both original Bearing Trees Set Stone 5 x 6½ x 20 over drilled hole filled with lime				
7	Found remains of original Sugartree, Elm taken by Barber still standing Set rock 5 x 7 x 22 over drilled hole filled with lime				
8	Bearing trees taken by Barber still standing Drilled a hole with Crow bar and filled it with lime				
9	Found remains of Barber's Bearing Trees and mound west on true NW Stone Set Stone 7 x 12 x 19 over hole filled with lime				
19	Set Stone 5 x 5½ x 18 over drilled hole filled with lime				
23	Filled a drilled hole with lime				
26	Set Stone	4 x	14 x 24	over	drilled hole filled with lime
27	Set Stone	4 x	8 x 14	"	" " " " " " "

CERTIFICATE OF SURVEY.

STATE OF WISCONSIN, } ss.
GRANT COUNTY,

I, Charles S. Sampson, County Surveyor in and for the County and State aforesaid, do hereby certify that I have executed the Survey represented by the foregoing Plat and annexed Field Notes of Survey, in accordance with the State Laws and Instructions of the Commissioner of the General Land Office. Scale, 80 chains to 4 inches. The figures in red ink are the lengths of the lines as stated in the Field Notes of the Government Survey.

Declination of the Magnetic Meridian from the True Meridian 0° East. The variation of needle adopted in establishing corners is 0° East.

WITNESS my hand this 18th day of October A. D. 1899.

Albert Barney Jr
Andrew Otto } CHAINMEN.

Charles S. Sampson SURVEYOR.