Section 6 Township 3 North Range 3 West of 4th P. M.

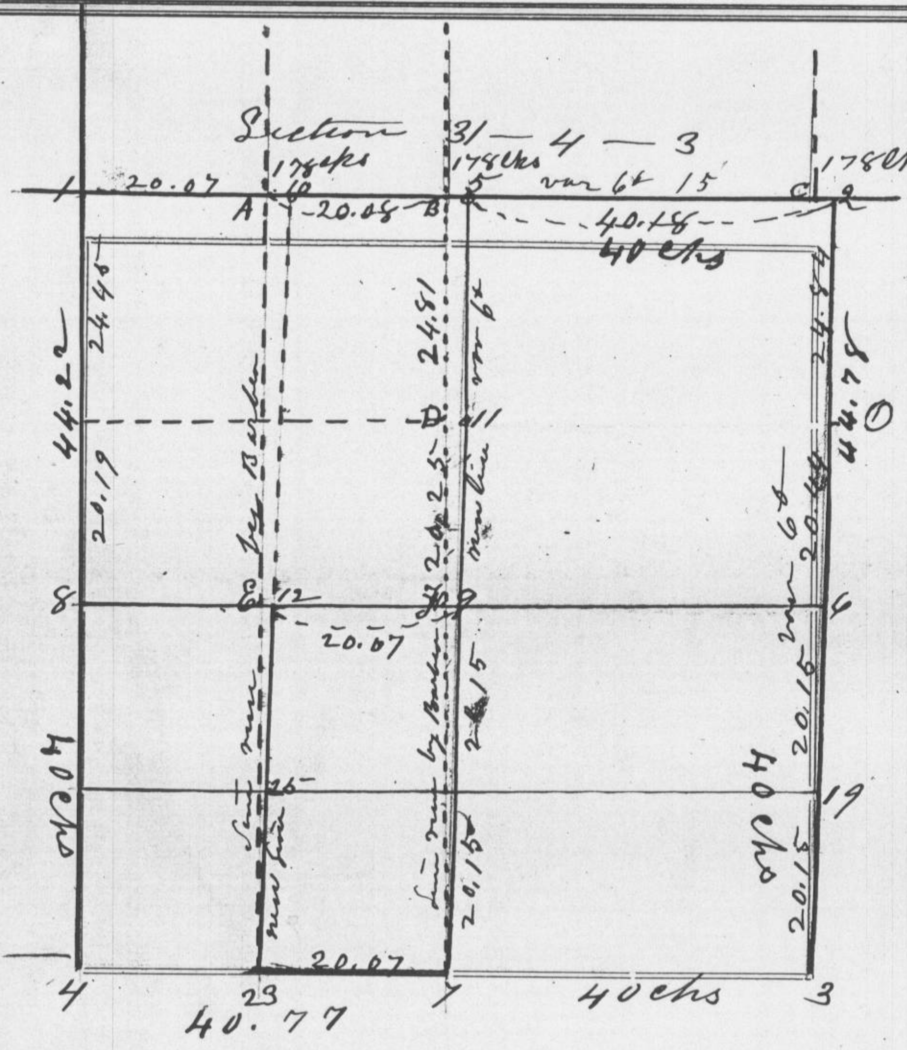

Corners	Bearing Trees	In. Dia.	Courses they Bear	Links Distant	REMARKS
1	Found remains of Original Elm bearing tree also Sugar bearing taken by Barber in 1880				
	Red Oak	24	N 19° E	93 } new	
	Sugar	12	N 55½ E	137½ }	Stone 4×7×22 over drilled hole filled with lime
2	Original bearing gone but found by me in 1892				
3	One original bearing standing Found Stone at Corner				
5	Drove Stake at a point ~~midway~~ between 1 & 2 1.78 chs ~~links~~ east of ¼ cor for Sec 31—4—3				
6	Stump of original Red oak standing				
7	Original Burr oak Standing Found Stone at Corner				
9	Set Stake				
11	" "				
12	" " "				
25	" " "				
A	Same as 23 for Sec 31—4—3 Rs set by Barber see page 52 this volume				
B	Same as 7 " " " " " found " " " " " "				
C	Same as 3 " " " " " See page 284 this volume				
D	Same as 11 on page 52 this vol found Stump of S.W. tree and decayed remains of N.E. one				
E	" " 12 " " " " " " " " S.E. " "				
F	" " 9 " " " " " " Both of Barber's bearing trees standing				
		D to 11	124 lks		
		F " 9	83 " "		
		E " 12	85 " "		
O	By Mahood in 1849 & Stumps of both of his bearing trees standing				

CERTIFICATE OF SURVEY.

STATE OF WISCONSIN,
GRANT COUNTY, } ss.

I, Charles Sampson, County Surveyor in and for the County and State aforesaid, do hereby certify that I have executed the Survey represented by the foregoing Plat and annexed Field Notes of Survey, in accordance with the State Laws and Instructions of the Commissioner of the General Land Office. Scale, 80 chains to 4 inches. The figures in red ink are the lengths of the lines as stated in the Field Notes of the Government Survey.

Declination of the Magnetic Meridian from the True Meridian 6° East. The variation of needle adopted in establishing corners is ________ East.

WITNESS my hand this 15th day of December A. D. 1899

Thos Hartman
James Hodvaal } CHAINMEN.

Charles Sampson SURVEYOR.