ection 30 Township 8 North Range 1 West of 4th P. M.

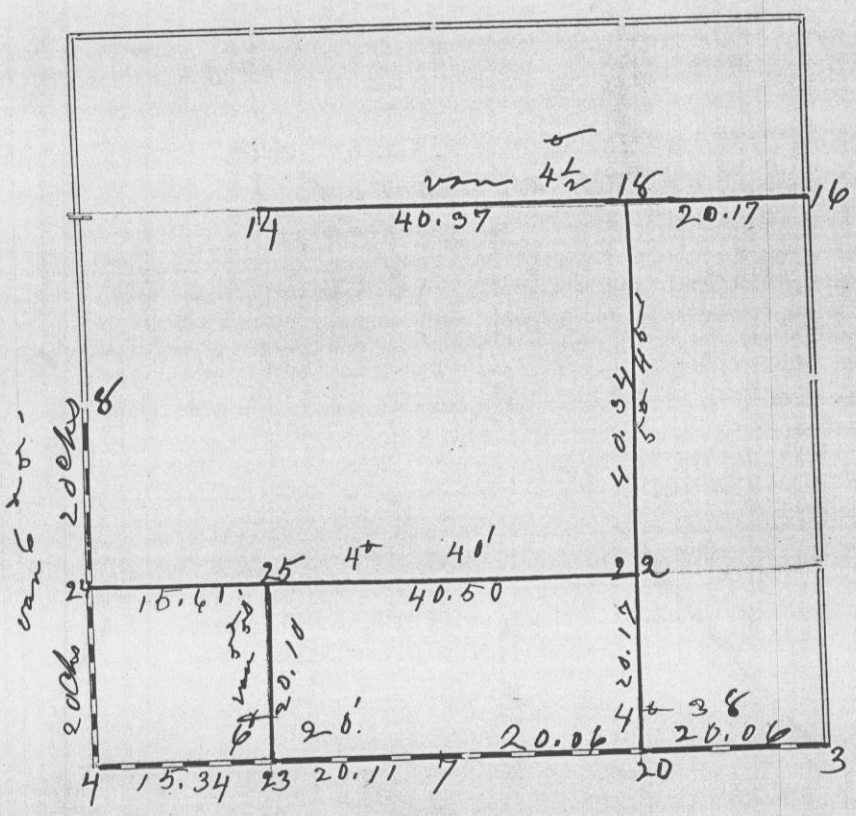

210

Corners	Bearing Trees	In. Dia.	Courses they Bear	Links Distant	REMARKS
3	See page 289				
4	Found decayed stumps of both				original B. T.'s
7	Found pile of rocks ~~at~~ and stake				at Cor and ~~95.24~~ 75.74 of ~~both~~ 5 B. T.'s 40.50
8	See page	289	Barker's		B. T. Stake ~~B. T.~~ 45 21 75.74 75.24 25.50 3'
14	" " " "				
16	" " " "				
18	1st flint rock				14×12×4 pointed at top at Cor
	" " "				14×12×3 flaked 50 lks 8th of Cor
	" " "		Triangular		12×8×6 50 lks East of Cor
23	flint rock				14×8×6 at Cor
	Sand " "				16×6×4 set 50 lks North of Cor
	" " " "				14×4×6 " 50 lks South " "
22	rock				15×9×16 Set at Cor
	" "				14×6×4 pointed top set 50 lks North of Cor
	" "				16×12×4 Set 50 lks West of Corner
24	White Oak	18	East	42	Flint rock 14×10×4 set 50 lks North
	Black "	20	" "	13	" " 14×12×6 " at corner
25	Sandrock				18×12×3 Set at Cor
	" "				13×6×4 " 50 lks East
	" "				12×4×6 pointed Set 100 lks South
20	Sandrock				pointed at top 16×12×2 Set at Corner
	" "				18×12×4 set 50 lks East of Cor
	" "				18×12×4 " 50 " South

CERTIFICATE OF SURVEY.

STATE OF WISCONSIN, GRANT COUNTY, } ss.

I, Charles Dampson, County Surveyor in and for the County and State aforesaid, do hereby certify that I have executed the Survey represented by the foregoing Plat and annexed Field Notes of Survey, in accordance with the State Laws and Instructions of the Commissioner of the General Land Office. Scale, 80 chains to 4 inches. The figures in red ink are the lengths of the lines as stated in the Field Notes of the Government Survey.

Declination of the Magnetic Meridian from the True Meridian 6° East. The variation of needle adopted in establishing corners is 6° East.

WITNESS my hand this 15th day of May A. D. 1861

Chainmen.

C. C. Dampson Surveyor.