Section 27 Township 3 North Range 3 West of 4th P. M.

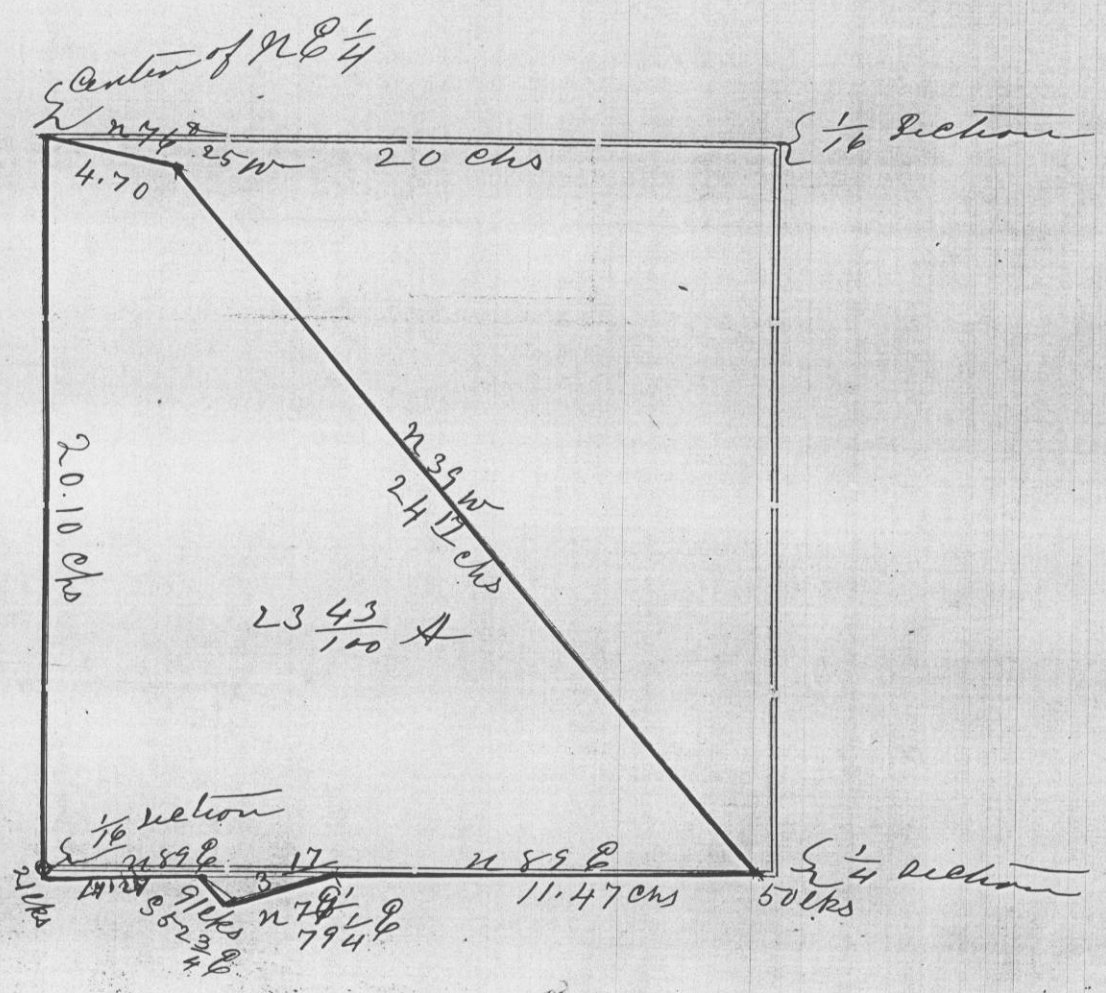

Corners	Bearing Trees	In. Dia.	Courses they Bear	Links Distant	REMARKS
					The above is the plat of a parcel of land described in a deed from Wm. F. Emmons to Bhelapar and Casper Burggraf ~~Det~~ recorded Sept 10th 1856 in Book 17 of Deeds page 108 also in a deed from Burggraf to J. D. Greenfield for ~~18~~ 1901

CERTIFICATE OF SURVEY.

STATE OF WISCONSIN, } ss.
GRANT COUNTY,

I, Charles Dampson, County Surveyor in and for the County and State aforesaid, do hereby certify that I have executed the Survey represented by the foregoing Plat and annexed Field Notes of Survey, in accordance with the State Laws and Instructions of the Commissioner of the General Land Office. Scale, 80 chains to 4 inches. The figures in red ink are the lengths of the lines as stated in the Field Notes of the Government Survey.

Declination of the Magnetic Meridian from the True Meridian 6° East. The variation of needle adopted in establishing corners is ..... East.

WITNESS my hand this 18th day of Day of Jan A. D. 18 1902

Simon Dampsolaf
A Tanden Burkhart } CHAINMEN.

C. C. Dampson SURVEYOR.