Section 21 Township 7 North Range 2 West of 4th P. M.

294

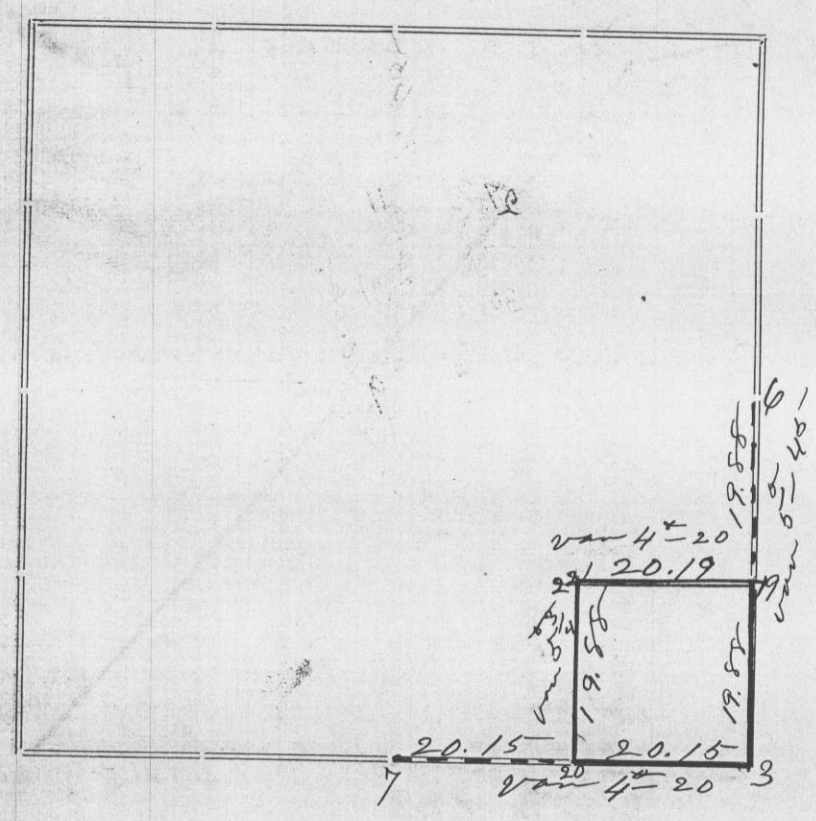

Corners	Bearing Trees	In. Dia.	Courses they Bear B. T.	Links Distant	REMARKS
6	South west original Stump of N.E. brg		Still Standing Still Standing		but dead
3	Found decayed		remains of both		original Bearing Tree
7	North west original bearing Found decayed		Found remains of S.E. original bearing		
At	19, 20 & 22		Drove stakes		

STATE OF WISCONSIN, }
GRANT COUNTY, } ss.

CERTIFICATE OF SURVEY.

I, Charles Samson, County Surveyor in and for the County and State aforesaid, do hereby certify that I have executed the Survey represented by the foregoing Plat and annexed Field Notes of Survey, in accordance with the State Laws and Instructions of the Commissioner of the General Land Office. Scale, 80 chains to 4 inches. The figures in red ink are the lengths of the lines as stated in the Field Notes of the Government Survey.

Declination of the Magnetic Meridian from the True Meridian 5 4 5 East. The variation of needle adopted in establishing corners is 6 East.

WITNESS my hand this 1st day of December A. D. 18 1902

John Butler
Lew Jones } CHAINMEN.

C. C. Samson SURVEYOR.